

MADISON

WATER WELL DRILLERS LOG

H 300

H
7-28-60

Date: 7-28, 1960, Driller: M. S. K. A. S. County: MADISON

(Name)

(1) Owner of Land: BILLY LEDBETTER
(Name)
CANTON MISS.
(Address)

Description & Color of Materials Sand, Clay, Red Clay, Shell, etc.	Thick-ness Feet	Depth Feet
WHITE CLAY	0-21	
BROWN CLAY	21-42	
BLUE CLAY	42-63	
"	63-84	
"	84-105	
"	105-126	
SAND CLAY	126-147	
SAND LIMSTONE	147-168	
"	168-189	
"	189-210	
MED TO COARSE SAND	210-231	
"	231-234	

(2) Location: 1/4, 7, 1/4, Sec. 21 T9 R3E,
8 miles NE, of CANTON,
(distance) (direction) (Nearest Town)

(3) Topography: ✓
(Hilly) (Flat) (Level)

(4) Purpose of Well: FARM
(Domestic Irrigation
Municipal, Industrial, Other)

Information upon completion of well:

(1) Diameter 2 inches.

(2) Total Depth 234 feet.

(3) Water Level 88 feet below top of ground.

(4) Cased to _____, Size _____

(5) Screen: Size 006, Length 10 FT.


(6) Were any formations sealed against pollution?
_____ yes, ✓ no.

If YES depth of formation _____

Why _____

Drillers Remarks: _____

SET 006 x 10-2"
234 ft
3 1/2" Pairing

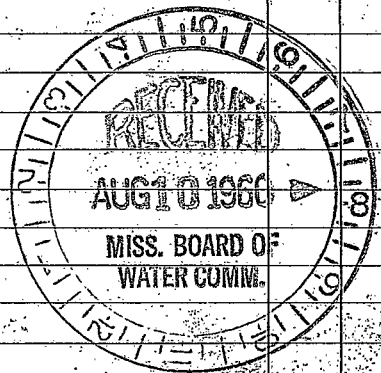

this copy for your office files.

(Use Back Side)

Well No.

