

Madison
H 2000
9-23-81

MISSISSIPPI
BOARD OF WATER COMMISSIONERS
416 North State Street
Jackson, Mississippi 39201

MADISON

WATER WELL DRILLERS LOG

9-23 1981 *R. J. J. Driller* ~~Leak~~
date well completed firm name county well located

LANDOWNER *Michael Madison*
Route 9 Box 119
Camden
(mailing address)

description of formations encountered	from	to
<i>Clay</i>	<i>0</i>	<i>10</i>
<i>Crack</i>	<i>10</i>	<i>12</i>
<i>Deep Sand</i>	<i>12</i>	<i>20</i>
<i>Sand</i>	<i>20</i>	<i>80</i>

WELL LOCATION:
sec *5* T *10* N R *4* E
12 miles *500* of *Camden*
(distance) (direction) (nearest town)

WELL PURPOSE *Water*
(home, irrigation, municipal, industrial)

- WELL COMPLETION DATA:
- (1) diameter (inches) *3 1/8"*
 - (2) total depth (feet) *85'*
 - (3) static water level (feet) *85'* below above top of ground.
 - (4) casing *2 1/2"* *80'*
(material) (depth)
 - 2 1/2"* if telescope see back.
(size)
 - (5) screen *5 1/2"* *80'*
(length) (depth to top)
 - 2 1/2"*
(size) (material)
 - (6) pump *1* *10*
(HP) (yield gpm)
 - Multi-stage*
(type power)
 - (7) electric log *None*
(yes or no)
 - (organization running log)

(8) how well bottom plugged *plug*

DRILLERS REMARKS:


DEPT. OF NATURAL RESOURCES
BUREAU OF LAND & WATER RESOURCES

OCT - 1 1981

RECEIVED

If well telescopes please sketch and show depths.

GROUND LEVEL

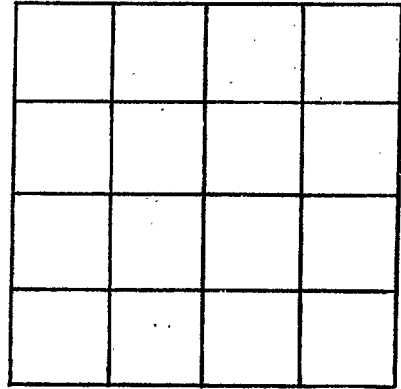

SECTION _____

Please indicate well location X.

ADDITIONAL INFORMATION

If more than one screen,
show locations of each on sketch.