

MADISON

H 2001

9-1-82

MISSISSIPPI BOARD OF WATER COMMISSIONERS 416 North State Street Jackson, Mississippi 39201

WATER WELL DRILLERS LOG

9-1 date well completed

1982 THOMAS SON firm name

Madison county well located

LANDOWNER: Mabel GARNER

description of formations encountered

from to

|                    |     |     |
|--------------------|-----|-----|
| Red Dirt           | 0   | 10  |
| Red Clay           | 10  | 25  |
| Fine White SAND    | 25  | 40  |
| CLAY MIX FINE SAND | 40  | 50  |
| Fine White SAND    | 50  | 65  |
| CHALK FINE SAND    | 65  | 80  |
| CHALK              | 80  | 105 |
| White SAND         | 105 | 123 |

Sharon Min (mailing address)

WELL LOCATION:

sec. 19 T 10 N R 4 E S W 3 miles N of SHARON (distance) (direction) (nearest town)

WELL PURPOSE: (home, irrigation, municipal, industrial)

WELL COMPLETION DATA:

- (1) diameter (inches) 2
- (2) total depth (feet) 123
- (3) static water level (feet) 60 below top of ground
- (4) casing PVC 113 (material) (depth) 2 (size) if telescope see back.
- (5) screen 10 113 (length) (depth to top) 2 PVC (size) (material)
- (6) pump 3/4 6 (HP) (yield gpm) Electric (type power)
- (7) electric log NO (yes or no)

(organization running log)

(8) how well bottom plugged Screen

DRILLERS REMARKS:

DEPT. OF NATURAL RESOURCES BUREAU OF LAND & WATER RESOURCES

SEP 7 1982


RECEIVED

If well telescopes please sketch and show depths.

GROUND LEVEL

MOZICAN

58-1-P

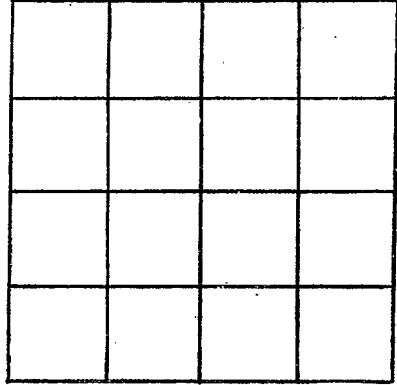

SECTION \_\_\_\_\_

Please indicate well location X.

ADDITIONAL INFORMATION

A series of horizontal lines for recording additional information, starting below the 'ADDITIONAL INFORMATION' header and extending to the bottom of the page.

If more than one screen, show locations of each on sketch.