

MISSISSIPPI DEPARTMENT OF NATURAL RESOURCES

Bureau of Land and Water Resources

Southport Mall

P.O. Box 10631

Jackson, Mississippi 39209

WATER WELL DRILLERS LOG

Madison
H 2002

3/15 1983

Thomas + son

Madison

date well completed

firm name

county well located

LANDOWNER: <u>Martha Branson</u>	description of formations encountered	from	to
<u>RT 2</u>	<u>Red Chalk</u>	<u>0</u>	<u>14</u>
<u>Camden Miss</u> (mailing address)	<u>Grey Chalk</u>	<u>14</u>	<u>26</u>
	<u>Red sand</u>	<u>26</u>	<u>28</u>
WELL LOCATION: sec. <u>17-10</u> <u>N</u> R. <u>4</u> <u>E</u> <u>20</u> miles <u>West</u> of <u>Carthage</u> (distance) (direction) (nearest town)	<u>Grey Chalk</u>	<u>28</u>	<u>42</u>
	<u>Red Chalk + sand</u>	<u>42</u>	<u>56</u>
	<u>White sand</u>	<u>56</u>	<u>95</u>
WELL PURPOSE: (home, irrigation, municipal, industrial)			
WELL COMPLETION DATA:			
(1) diameter (inches) <u>2"</u>			
(2) total depth (feet) <u>95'</u>			
(3) static water level (feet) <u>35</u> <u>below</u> top of ground.			
(4) casing <u>PVC</u> <u>95'</u> (material) (depth)			
<u>2"</u> (size) if telescope see back.			
(5) screen <u>10'</u> <u>85'</u> (length) (depth to top)			
<u>2"</u> <u>PVC</u> (size) (material)			
(6) pump <u>1</u> <u>10</u> (HP) (yield gpm)			
<u>Electric</u> (type power)			
(7) electric log <u>NO</u> (yes or no)			
(organization running log)			
(8) how well bottom plugged <u>Screen</u>			
DRILLERS REMARKS:			


DEPT. OF NATURAL RESOURCES
BUREAU OF LAND & WATER RESOURCES

MAR 17 1983

RECEIVED

If well telescopes please sketch and show depths.

GROUND LEVEL

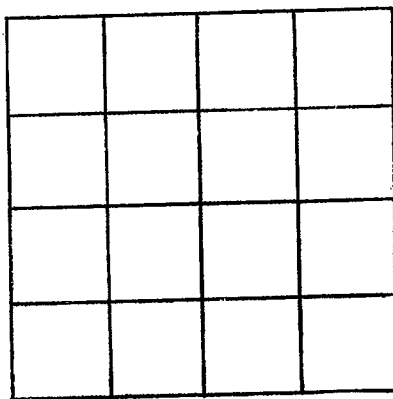

SECTION _____

Please indicate well location X.

ADDITIONAL INFORMATION

If more than one screen, show locations of each on sketch.