

MISSISSIPPI DEPARTMENT OF NATURAL RESOURCES
Bureau of Land and Water Resources
 Southport Mall
 P.O. Box 10631
 Jackson, Mississippi 39209
WATER WELL DRILLERS LOG

Madison
2003

11-9 1983 Thompson Madison
 date well completed firm name county well located

LANDOWNER: Leah's Market

description of formations encountered	from	to
<u>1st layer</u>	<u>0</u>	<u>10</u>
<u>2nd layer</u>	<u>10</u>	<u>20</u>
<u>3rd layer</u>	<u>20</u>	<u>30</u>
<u>4th layer</u>	<u>30</u>	<u>40</u>
<u>5th layer</u>	<u>40</u>	<u>50</u>
<u>6th layer</u>	<u>50</u>	<u>60</u>

6 N. 1st St
 (mailing address)

WELL LOCATION:
 sec. 32 T. 100 N. R. 4 E.
3 miles SE of Madison
 (distance) (direction) (nearest town)

WELL-PURPOSE:
 (home, irrigation, municipal, industrial)

WELL COMPLETION DATA:

- (1) diameter (inches) 4"
- (2) total depth (feet) 103'
- (3) static water level (feet) 30' below top of ground.
- (4) casing PVC, 103' (material) (depth)
4" (size) If telescope see back.
- (5) screen 10', 73' (length) (depth to top)
4" (size) PVC (material)
- (6) pump 3/4, 12 (HP) (yield gpm)
 (type power)
- (7) electric log no (yes or no)
 (organization running log)
- (8) how well bottom plugged clean

DEPT. OF NATURAL RESOURCES
 BUREAU OF LAND & WATER RESOURCES


DEC - 9 1983

RECEIVED

DRILLERS REMARKS:

If well telescopes please sketch and show depths.

GROUND LEVEL

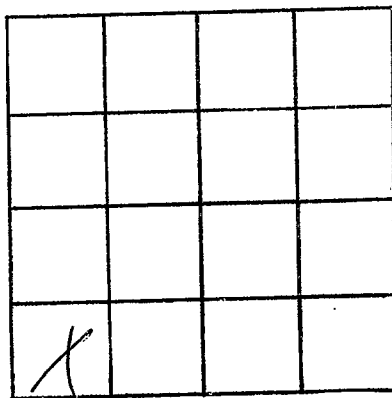

SECTION _____

Please indicate well location X.

ADDITIONAL INFORMATION

If more than one screen,
show locations of each on sketch.