

MISSISSIPPI DEPARTMENT OF NATURAL RESOURCES

Bureau of Land and Water Resources

Southport Mall

P.O. Box 10631

Jackson, Mississippi 39209

WATER WELL DRILLERS LOG

MADISON
H 2004

Aug. 31 1988
date well completed

E.M. Ed CRESSWELL MADISON
firm name

county well located

LANDOWNER:	description of formations encountered	from	to
(mailing address)			
<u>Shelby Smith</u> <u>Canton, Mo.</u>	<u>red sand</u>	<u>0</u>	<u>25</u>
	<u>grey shale</u>	<u>25</u>	<u>120</u>
	<u>dark shale</u>	<u>120</u>	<u>180</u>
	<u>sand & blue shale</u>	<u>180</u>	<u>320</u>
WELL LOCATION:			
sec. <u>30</u> T. <u>10</u> N R. <u>4</u> E			
<u>6</u> miles <u>NE</u> of <u>CANTON</u>			
(distance) (direction) (nearest town)			
WELL PURPOSE: <u>farm</u>			
(home, irrigation, municipal, industrial)			
WELL COMPLETION DATA:			
(1) diameter (inches) <u>4</u>			
(2) total depth (feet) <u>320</u>			
(3) static water level (feet) <u>80</u> below top of ground.			
(4) casing <u>PVC</u> <u>280</u>			
(material) (depth)			
<u>4</u> if telescope see back.			
(size)			
(5) screen <u>40</u> <u>280</u>			
(length) (depth to top)			
<u>4</u> <u>PVC</u>			
(size) (material)			
(6) pump <u>1 1/2</u> <u>30</u>			
(HP) (yield gpm)			
(type power)			
(7) electric log <u>no</u>			
(yes or no)			
(organization running log)			
(8) how well bottom plugged <u>hard & dark</u>			

RECEIVED


SEP 20 1988

Department of Natural Resources
Bureau of Land & Water Resources

DRILLERS REMARKS:

If well telescopes please sketch and show depths.

GROUND LEVEL

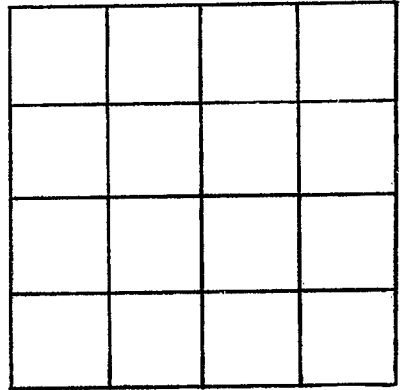

SECTION _____

Please indicate well location X.

ADDITIONAL INFORMATION

If more than one screen,
show locations of each on sketch.