

MADISON

WATER WELL DRILLERS LOG


Date: 31 16, 1966, Driller: J P Thornton County Madison
B-16-66 Bronson (Name)

(1) Owner of Land: J. B. Bronson
 (Name)
Center Farm Home Miss
 (Address)
 (2) Location: 1/4, 1/4, Sec. T. R.
3 miles E, of Farm Home
 (distance) (direction) (Nearest Town)
 (3) Topography: Hilly
 (Hilly) (Flat) (Level)
 (4) Purpose of Well: Domestic
 (Domestic Irrigation
 Municipal, Industrial, Other)

Description & Color of Materials Sand, Clay, Red Clay, Shell, etc.	Thick- ness Feet	Depth Feet
<u>red clay</u>	<u>2.5</u>	<u>ft</u>
<u>fine sand. red.</u>	<u>5</u>	
<u>Black dirt</u>	<u>1.56</u>	
<u>rock + sand mixed</u>	<u>2.5</u>	
<u>Black sand</u>	<u>6.5</u>	
<u>Rock</u>	<u>8</u>	
<u>gray water sand</u>	<u>4.5</u>	
	<u>32.3</u>	

Information upon completion of well:

(1) Diameter 2 inches.
 (2) Total Depth 323 feet.
 (3) Water Level 30 feet below top of ground.
 (4) Cased to 273, Size 2.
 (5) Screen: Size Open Well, Length .
 (6) Were any formations sealed against pollution?
 yes, X no.

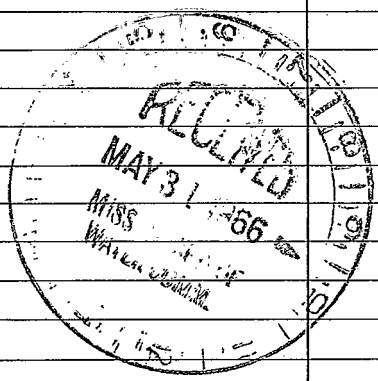

If YES depth of formation
 Why

Drillers Remarks: 350 gal Dr hr.

(Use Back Side)

Well No.

