

E Log 157

MISSISSIPPI  
BOARD OF WATER COMMISSIONERS  
416 North State Street  
Jackson, Mississippi 39201

coded

WATER WELL DRILLERS LOG

**CODED**

Madison  
J 24  
2-68  
MS-GW-3427

2-12-1968  
date well completed

Leape-Central Co.  
firm name

county well located

LANDOWNER: East Madison  
Water Association, Inc  
Canton, Miss.  
(mailing address)

description of formations  
encountered

from to

Clay	0	100
Clay and Sandy Shale	100	265
Rock	265	266
Shale breaks, Rock	266	300
Clay	300	338
Rock	338	339
Sandy Clay	339	433
Sand	433	502
Sandy Clay	502	562
Sand	562	638
Sand, streaks of clay	638	655

WELL LOCATION:  
sec. 31 T. 10 N. R. 5 E.  
S W  
16 miles East of Canton  
(distance) (direction) (nearest town)


WELL PURPOSE: Domestic  
(home, irrigation, municipal, industrial)

WELL COMPLETION DATA:

- (1) diameter (inches) 10"
- (2) total depth (feet) 642'
- (3) static water level (feet) 100' below top of ground.
- (4) casing Steel, 580' (material) (depth)  
(size) if telescope see back.
- (5) screen 50' length, 585' depth to top  
6" Stainless Steel (size) (material)
- (6) pump 40 (HP) (yield gpm)  
Electric (type power)
- (7) electric log ~~no~~ yes (yes or no)  
MGS (organization running log)
- (8) how well bottom plugged Valve

DRILLERS REMARKS:

Pump not installed  
as of this date -

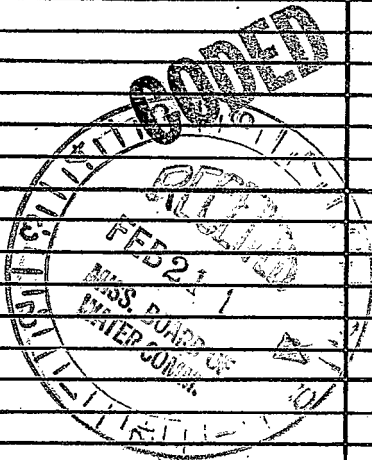

Ⓢ

If well telescopes please sketch and show depths.

GROUND LEVEL

N<sup>1</sup>/<sub>2</sub>, SE


SECTION 31

Please indicate well location X.

ADDITIONAL INFORMATION

If more than one screen, show locations of each on sketch.