

MISSISSIPPI
BOARD OF WATER COMMISSIONERS
416 North State Street
Jackson, Mississippi 39201

CODED

WATER WELL DRILLERS LOG

MADISON
J 25
11-7-69

11-7-1969 date well completed
J P Thornton firm name
Madison county well located

LANDOWNER: Earsol Harris
Bt
Ofahoma Miss
(mailing address)

description of formations encountered	from	to
Red clay	15'	
Red sand	28	
White sand	21	
	56	

WELL LOCATION:
sec. 13 T 10 N R 5 E
4 miles NW of Ofahoma
(distance) (direction) (nearest town)

WELL PURPOSE: Domestic
(home, irrigation, municipal, industrial)

- WELL COMPLETION DATA:
- (1) diameter (inches) 11-7-69
 - (2) total depth (feet) 56
 - (3) static water level (feet) 48 below above top of ground.
 - (4) casing gal 51
(material) (depth)
if telescope see back.
(size)
 - (5) screen 5x1 1/4
(length) (depth to top)
1 1/4 x 5 screen type
(size) (material)
 - (6) pump 1/2 325 gal Bt
(HP) (yield gpm)
(type power)
 - (7) electric log X
(yes or no)
(organization running log)
 - (8) how well bottom plugged screen


Feb. 2 - 1970

MISS. BD. OF
WATER COMMISSIONERS

DRILLERS REMARKS: 325 gal Bt

If well telescopes please sketch and show depths.

GROUND LEVEL

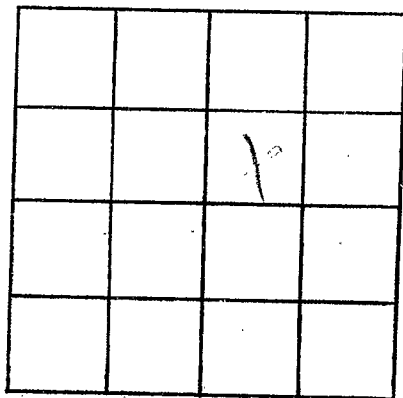

SECTION 13

Please indicate well location X.

ADDITIONAL INFORMATION

If more than one screen,
show locations of each on sketch.