

J 26
8-26-63

WATER WELL DRILLERS LOG

CODED

Date: 8/24, 1963, Driller: M. McKay County Madison
(Name)

- (1) Owner of Land: David Wallace
(Name)
Sharon Mus
(Address)
- (2) Location: 1/4, 1/4, Sec. 29 T. 10 R. 5
10 miles East of Sharon
(distance) (direction) (Nearest Town)
- (3) Topography: (Hilly) (Flat) (Level)
- (4) Purpose of Well: Domestic Irrigation
 Municipal Industrial, Other

Description & Color of Materials Sand, Clay, Red Clay, Shell, etc.	Thick- ness Feet	Depth Feet
Hole from 0-210		
Was drilled by		
THE ANTON DULY of		
Carthage miss		
McKAY STARTED		
AT 210	210	231
Rock	231	232 1/2
Shale - Rock	232 1/2	252
" "	252	294
Brown Sandy clay	294	334
Fine Sand	336	357
Fine Sand	357	441
Medium Sand	441	483


Information upon completion of well:

- (1) Diameter 2 inches.
- (2) Total Depth 483 feet.
- (3) Water Level 73 feet below top of ground.
- (4) Cased to _____, Size _____
- (5) Screen: Size 007, Length 20
- (6) Were any formations sealed against pollution?
_____ yes, no.

If YES depth of formation _____
Why _____
Drillers Remarks: _____

5 H.P. air unit.

CODED

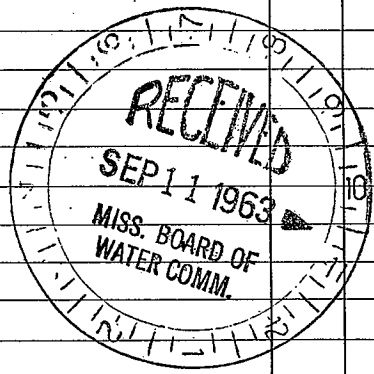

Well No.

(Use Back Side)

