

J27
11-4-63

WATER WELL DRILLERS LOG **CODED**

4

Date: 11/4, 1963, Driller: M Kay County Madison
(Name)

(1) Owner of Land: Ola Finn
(Name)
Frampton Mas
(Address)

(2) Location: 1/4, 1/4, Sec. 35 10 R5E,
16 miles E, of Canton,
(distance) (direction) (Nearest Town)

(3) Topography: (Hilly) (Flat) (Level)

(4) Purpose of Well: Home
(Domestic Irrigation
Municipal, Industrial, Other)

| Description & Color of Materials Sand, Clay, Red Clay, Shell, etc. | Thick- ness Feet | Depth Feet |
|---|------------------------|---------------|
| <u>White Clay</u> | <u>0</u> | <u>21</u> |
| <u>Yellow clay</u> | <u>21</u> | <u>42</u> |
| <u>Blue clay</u> | <u>42</u> | <u>63</u> |
| <u>10</u> | <u>63</u> | <u>84</u> |
| <u>84</u> | <u>84</u> | <u>105</u> |
| <u>Fin Sandy clay</u> | <u>105</u> | <u>126</u> |
| <u>126</u> | <u>126</u> | <u>147</u> |
| <u>Med Sand</u> | <u>147</u> | <u>173</u> |

Information upon completion of well:

(1) Diameter 2 inches.

(2) Total Depth 173 feet.

(3) Water Level 46 feet below top of ground.


(4) Cased to _____, Size _____

(5) Screen: Size 007, Length 5 ft

(6) Were any formations sealed against pollution?
_____ yes, no.

Hand Pump

CODED

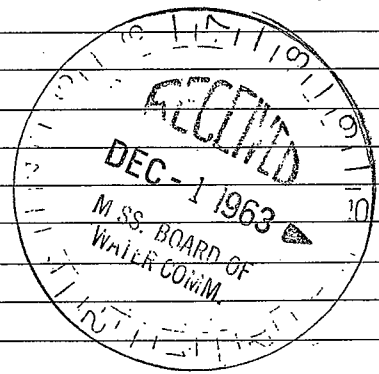

If YES depth of formation _____

Why _____

Drillers Remarks: _____

(Use Back Side)

Well No.

