

MADISON

WATER WELL DRILLERS LOG

J28

Date: 5/15/65, 19

Driller: M'KAY

CODED

County MADISON

5-15-65

(Name)

(1) Owner of Land: Clarence Ray
(Name)
Sharon Mui
(Address)

Description & Color of Materials Sand, Clay, Red Clay, Shell, etc.	Thick- ness Feet	Depth Feet
<u>Red Clay</u>	<u>15</u>	<u>15</u>
<u>Sand</u>	<u>15</u>	<u>47</u>

(2) Location: $\frac{1}{4}$, $\frac{1}{4}$, Sec. 20/29 T10RS,
7 miles S, of Camden
(distance) (direction) (Nearest Town)

(3) Topography: (Hilly) (Flat) (Level)

(4) Purpose of Well: Farm
(Domestic Irrigation
Municipal, Industrial, Other)

Bad Pump

Information upon completion of well:

(1) Diameter 2 inches.

(2) Total Depth 47 feet.

(3) Water Level 3 feet below top of ground.

(4) Cased to _____, Size _____

(5) Screen: Size 007, Length 5


(6) Were any formations sealed against pollution?
_____ yes, no.

If YES depth of formation _____

Why _____

Drillers Remarks: _____

CODED

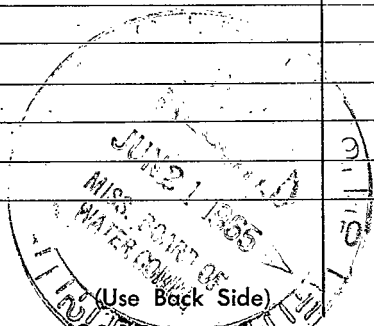

Well No.

1870
1871
1872
1900