

J 31

WATER WELL DRILLERS LOG

6-7-62

CODED

Date: 4-7, 1962, Driller: Pearson Drilling Co. County Madison

(Name)

(1) Owner of Land: C H Alexander (Name)

R L Saunders Mrs (Address)

(2) Location: 1/4, 1/4, Sec 2, T R

6 miles SE of Camden (distance), (direction), (Nearest Town)

(3) Topography: Hilly (Hilly), (Flat), (Level)

(4) Purpose of Well: Domestic (Domestic Irrigation, Municipal, Industrial, Other)

Description & Color of Materials Sand, Clay, Red Clay, Shell, etc.

Thick-ness Feet

Depth Feet

Hard Clay	20	20
Deep Stone & Sand	17	37
Mixture sand & clay	38	75
Gray sand	10	85

Information upon completion of well:

(1) Diameter 2 inches.

(2) Total Depth 85 feet.

(3) Water Level 42 feet below top of ground.

(4) Cased to, Size 2

(5) Screen: Size 1/4 x 6, Length 6'

(6) Were any formations sealed against pollution?


yes, no.

If YES depth of formation

Why

Drillers Remarks:

CODED

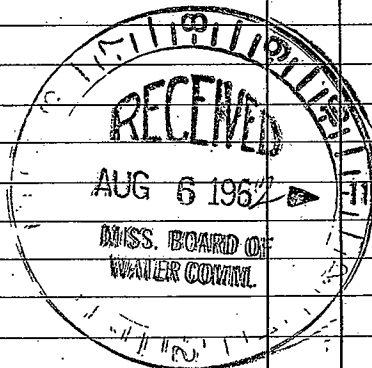

(Use Back Side)

Well No.

[The page contains extremely faint and illegible text, likely bleed-through from the reverse side of the document. No specific words or phrases can be discerned.]