

MADISON MISSISSIPPI BOARD OF WATER COMMISSIONERS

J33

9-20-62

WATER WELL DRILLERS LOG

CODED

Date: 9-20, 1962, Driller: Henson County: Madison

(Name)

(1) Owner of Land: R.L. Martin
(Name)

Farmington
(Address)

(2) Location: SE 1/4, SE 1/4, Sec. 25 T10 S
3/4 miles NE of Farmington
(distance) (direction) (Nearest Town)

(3) Topography: Hilly
(Hilly) (Flat) (Level)

(4) Purpose of Well: Domestic Fin
(Domestic Irrigation, Municipal, Industrial, Other)

Description & Color of Materials Sand, Clay, Red Clay, Shell, etc.	Thick- ness Feet	Depth Feet
<u>Yellow Clay</u>	<u>18</u>	<u>18</u>
<u>White clay</u>	<u>8</u>	<u>26</u>
<u>Cream Sand Fine</u>	<u>4</u>	<u>30</u>
<u>White clay</u>	<u>9</u>	<u>39</u>
<u>Sand</u>	<u>1</u>	<u>40</u>
<u>Gray Blue Clay</u>	<u>19</u>	<u>59</u>
<u>Sand</u>	<u>3</u>	<u>62</u>
<u>Gray Clay Sand</u>	<u>58</u>	<u>120</u>
<u>Dark Gray Pebbles</u>	<u>24</u>	<u>144</u>
<u>Gray Clay</u>	<u>5</u>	<u>149</u>
<u>Sand</u>	<u>2</u>	<u>151</u>
<u>Dark Gray Clay</u>	<u>29</u>	<u>180</u>

Information upon completion of well:

(1) Diameter 2 inches.

(2) Total Depth 145 feet.

(3) Water Level 33 feet below top of ground.

(4) Cased to 120, Size 2

(5) Screen: Size 2 1/2, Length 5

(6) Were any formations sealed against pollution?


no

If YES depth of formation

Why

Drillers Remarks:

CODED

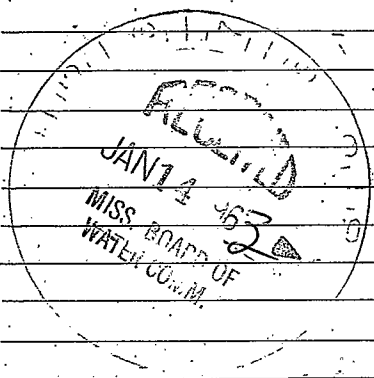

(Use Back Side)

Well No.

10-1-57

