

MS-GW-3498

MISSISSIPPI
BOARD OF WATER COMMISSIONERS
416 North State Street
Jackson, Mississippi 39201

CODED

MADISON
J34
7173
Flow #226

WATER WELL DRILLERS LOG

6-11 1973 Singer-Lump Central Dist. Madison
date well completed firm name county well located


LANDOWNER:	description of formations encountered	from	to
East Madison Water Association Canton, Miss. (mailing address)			
WELL LOCATION: sec. 24 T 10 N R 5 E			
WELL PURPOSE: Domestic (home, irrigation, municipal, industrial)			
WELL COMPLETION DATA:			
(1) diameter (inches) 8"			
(2) total depth (feet) 597'			
(3) static water level (feet) 145' below top of ground.			
(4) casing Steel, 540' (material) (depth) 8" (size) if telescope see back. + 37' 7 6"			
(5) screen 50' (length), 544' (depth to top) 6" (size), stainless steel (material)			
(6) pump 20 (HP), 225 (yield gpm) Electric (type power)			
(7) electric log yes (yes or no) Miss. Geo. Survey (organization running log)			
(8) how well bottom plugged Unloc			
DRILLERS REMARKS:			

JUL 13 1973



If well telescopes please sketch and show depths.

GROUND LEVEL

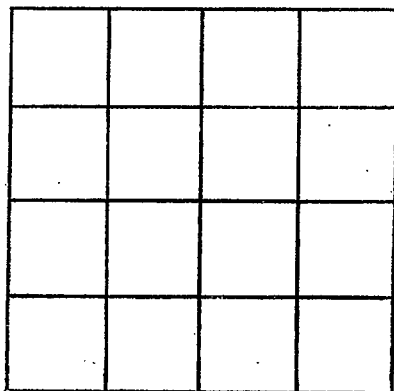

SECTION _____

Please indicate well location X.

ADDITIONAL INFORMATION

If more than one screen, show locations of each on sketch.