

MADISON
 J37
 7-11-77
 E Log # 244

MISSISSIPPI
 BOARD OF WATER COMMISSIONERS
 416 North State Street
 Jackson, Mississippi 39201

CODED

WATER WELL DRILLERS LOG

July 11 1977 E.M. "Bud" CRESSWELL Madison
 date well completed firm name county well located

LANDOWNER:	description of formations encountered	from	to
Joe Rule			
FLORA, Ms. (mailing address)	Clay-yellow	0	50
	Clay	50	250
	Blue	250	380
	Sand	380	410
	Sandy shale	410	500
	Sand	500	600
WELL LOCATION: sec. 35 T 9 N R 1 E W 3 miles NE of FLORA (distance) (direction) (nearest town)			
WELL PURPOSE: home (home, irrigation, municipal, industrial)			
WELL COMPLETION DATA:			
(1) diameter (inches) 2			
(2) total depth (feet) 600			
(3) static water level (feet) 90 below top of ground.			
(4) casing Steel 580 (material) (depth)			
2 If telescope see back. (size)			
(5) screen 20 580 (length) (depth to top)			
2 STAINLESS (size) (material)			
(6) pump air compressor (HP) (yield gpm)			
0 (type power)			
(7) electric log yes (yes or no) Hall (organization running log)			
(8) how well bottom plugged Steel plug			
DRILLERS REMARKS:			

CODED


RECEIVED

AUG 12 1977

MISS. RD. OF WATER COMM.

If well telescopes please sketch and show depths.

GROUND LEVEL

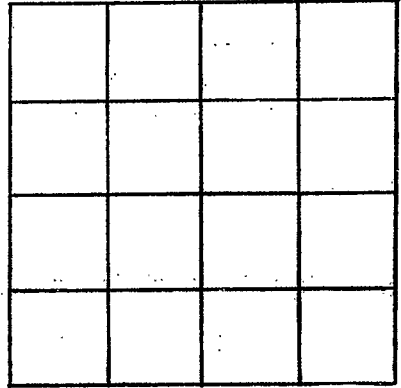

SECTION _____

Please indicate well location X.

ADDITIONAL INFORMATION

If more than one screen, show locations of each on sketch.