

MADISON

WATER WELL DRILLERS LOG

J 301

8-31-60

Date Aug 31, 1960, Driller: M. KAY Dulla County MADISON

(Name)

(1) Owner of Land: W. E. Bullock
(Name)
Camden Miss
(Address)

(2) Location: 1/4, 1/4, Sec. 25 T11 R3E
5 miles S, of Camden
(distance) (direction) (Nearest Town)

(3) Topography: (Hilly) (Flat) (Level)

(4) Purpose of Well: Home
(Domestic Irrigation, Municipal, Industrial, Other)


Description & Color of Materials Sand, Clay, Red Clay, Shell, etc.	Thick- ness Feet	Depth Feet
Red SAND	0	21
WHITE CLAY	21	42
WHITE Clay & Sand	42	63
SAND WHITE	63	84
" "	84	105
BLUE SAND	105	126
" "	126	127
ROD PUMP		

Information upon completion of well:

- (1) Diameter 2 inches.
- (2) Total Depth 127 feet.
- (3) Water Level 60 feet below top of ground.
- (4) Cased to _____, Size _____.
- (5) Screen: Size 009, Length 10ft.
- (6) Were any formations sealed against pollution?
_____ yes, _____ no.

If YES depth of formation _____
Why _____

Drillers Remarks: _____

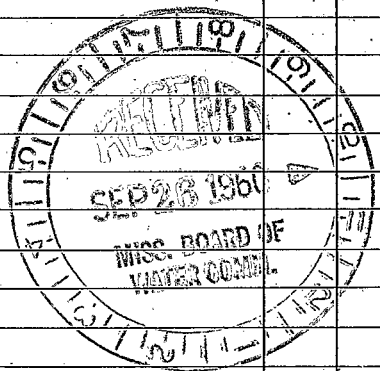

(Use Back Side)

Well No.

