

J 200
2-28-63

WATER WELL DRILLERS LOG

Date: 2-28, 1963, Driller: J.P. Thornton County: Madison
(Name)

(1) Owner of Land: Joe Harris
(Name)
Farm Haven miss
(Address)

(2) Location: 1/4, 1/4, Sec. 32 T10R5E
6 miles north, of Farm Haven
(distance) (direction) (Nearest Town)

(3) Topography: hilly
(Hilly) (Flat) (Level)

(4) Purpose of Well: Domestic
(Domestic Irrigation
Municipal, Industrial, Other)

Description & Color of Materials Sand, Clay, Red Clay, Shell, etc.	Thick- ness Feet	Depth Feet
<u>yellow clay</u>	<u>45</u>	
<u>red sand</u>	<u>4</u>	
<u>Black dirt</u>	<u>100</u>	
<u>Rock</u>	<u>3</u>	
<u>fine Black sand</u>	<u>52</u>	
<u>Rock</u>	<u>35</u>	
<u>fine dark gray sand</u>	<u>49</u>	
<u>Rock</u>	<u>7</u>	
<u>Shell</u>	<u>20</u>	
<u>Rock</u>	<u>2</u>	
<u>white water sand</u>	<u>26</u>	
	<u>2</u>	<u>43</u>

Information upon completion of well:

(1) Diameter 2 inches.

(2) Total Depth 343 feet.

(3) Water Level 73 feet below top of ground.


(4) Cased to 294, Size 2"

(5) Screen: Size 7 1/4, Length 6 ft

(6) Were any formations sealed against pollution?
_____ yes, _____ no.

If YES depth of formation _____
Why _____

Drillers Remarks: 350 gal per hr.

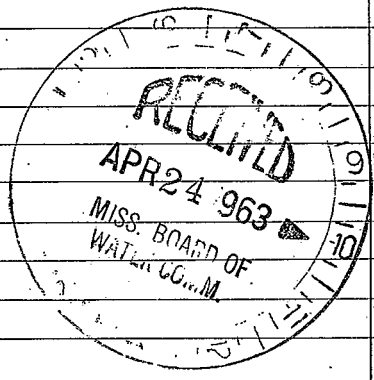

(Use Back Side)

Well No.

