

MADISON MISSISSIPPI

J 200

7-64

WATER WELL DRILLERS LOG

Date: 7/7, 1964, Driller: M. Kay County Madison
(Name)

(1) Owner of Land: Jarshawn Chuck
(Name)
Sharon mini
(Address)

(2) Location: 1/4, 1/4, Sec. 27 T10 R56
13 miles E of Canton
(distance) (direction) (Nearest Town)

(3) Topography: (Hilly) (Flat) (Level)

(4) Purpose of Well: Church
(Domestic Irrigation
Municipal, Industrial, Other)

Description & Color of Materials Sand, Clay, Red Clay, Shell, etc.	Thick- ness Feet	Depth Feet
<u>White Clay</u>	<u>0</u>	<u>20</u>
<u>"</u>	<u>20</u>	<u>40</u>
<u>White Sandy Clay</u>	<u>40</u>	<u>60</u>
<u>"</u>	<u>60</u>	<u>80</u>
<u>Singite Sand</u>	<u>80</u>	<u>100</u>
<u>Brown Clay Singite</u>	<u>100</u>	<u>120</u>
<u>"</u>	<u>120</u>	<u>140</u>
<u>Fine Sandy clay</u>	<u>140</u>	<u>160</u>
<u>10ft fine 10ft med Sand</u>	<u>160</u>	<u>180</u>

Information upon completion of well:

(1) Diameter 2 inches.

(2) Total Depth 180 feet.

(3) Water Level 30 feet below top of ground.

(4) Cased to _____, Size _____

(5) Screen: Size 007, Length 10

(6) Were any formations sealed against pollution?


_____ yes, no.

If YES depth of formation _____

Why _____

Drillers Remarks: _____

Jet Pump

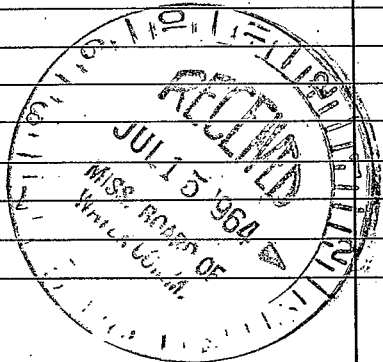

(Use Back Side)

Well No.

