

MISSISSIPPI DEPARTMENT OF NATURAL RESOURCES
Bureau of Land and Water Resources
 Southport Mall
 P.O. Box 10631
 Jackson, Mississippi 39209
WATER WELL DRILLERS LOG

Madison
J 2003

2-16-19 83 Thomas + son Madison
 date well completed firm name county well located

LANDOWNER: <u>Tom Souther</u> <u>RT 4 km</u>	description of formations encountered	from	to
<u>CARRIAGE WISE</u> (mailing address)	<u>Red clay</u>	<u>0</u>	<u>4</u>
WELL LOCATION:	<u>Red clay + chalk</u>	<u>4</u>	<u>16</u>
sec. <u>13</u> T <u>10</u> S R <u>E</u> W	<u>Grey sand + chalk</u>	<u>16</u>	<u>66</u>
<u>13</u> miles <u>West</u> of <u>Clarks</u> (distance) (direction) (nearest town)	<u>White sand + chalk</u>	<u>66</u>	<u>74</u>
WELL PURPOSE: (home, irrigation, municipal, industrial)	<u>Grey sand</u>	<u>74</u>	<u>103</u>
WELL COMPLETION DATA:			
(1) diameter (inches) <u>2"</u>			
(2) total depth (feet) <u>112'</u>			
(3) static water level (feet) <u>15</u> <u>below</u> above top of ground.			
(4) casing <u>PVC</u> <u>112'</u> (material) (depth) <u>2"</u> (size) if telescope see back.			
(5) screen <u>10'</u> <u>93'</u> (length) (depth to top) <u>2"</u> <u>PVC</u> (size) (material)			
(6) pump <u>1</u> <u>8</u> (HP) (yield gpm)			
<u>Electric</u> (type power)			
(7) electric log <u>NO</u> (yes or no)			
(organization running log)			
(8) how well bottom plugged <u>Screen</u>			
DRILLERS REMARKS:			


DEPT. OF NATURAL RESOURCES
 BUREAU OF LAND & WATER RESOURCES

FEB 24 1983

RECEIVED

If well telescopes please
sketch and show depths.

GROUND LEVEL

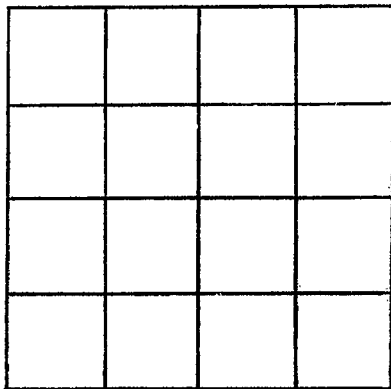

SECTION _____

Please indicate well location X.

ADDITIONAL INFORMATION

If more than one screen,
show locations of each on sketch.