

MISSISSIPPI DEPARTMENT OF NATURAL RESOURCES

Bureau of Land and Water Resources

P.O. Box 10631

Jackson, Mississippi 39209

WATER WELL DRILLERS LOG

COUNTY WELL LOCATED
Madison

WELL NUMBER *K 257* CODED

DATE WELL COMPLETED
6-29-90

PERMIT NUMBER:

NAME OF DRILLING FIRM
E. M. Dad General

Benton, Mo.

NAME & MAILING ADDRESS OF LANDOWNER
CRAFT FARMS

Rt. 1

Canton, Mo. 39046

WELL LOCATION: SEC *14* TOWNSHIP *9* RANGE *N 1 W*

DISTANCE *4* Miles DIRECTION *NE* of NEAREST TOWN *FLORA*

OTHER LANDMARK

WELL PURPOSE: Home, Irrigation, Municipal, Industrial, Fish Pond, etc.
test hole # 2

PUMP DATA

PUMP TYPE (Circle One):
Submersible, Turbine, Jet, Flowing Well,
Other (Describe) _____

POWER TYPE (Circle One):
Electric, Tractor, Diesel, Gasoline, Butane,
Other (Describe) _____ H/P _____

Pump Capacity (GPM) _____ No. of Stages _____ Setting Depth _____ FT.

PUMP TEST

Well yielded _____ GPM with
a drawdown of _____ ft.
after _____ hours of pumping

WELL DATA

Well Depth	Casing Diameter (In.)	Casing Length (Ft.)
Type of Casing	Hole Depth	Depth to Static Water Level

TYPE OF COMPLETION: (Circle One or More):
Gravel Packed, Underreamed, Telescoped,
Natural Development, Open Hole, Other
(Describe) _____

Top of Lap Pipe or Reduction in Casing

FEET IF TELESKOPED OR MORE THAN ONE SCREEN: USE BACK PAGE

LOG DATA

TYPE OF LOG RUN (Circle One):
Electric, Gamma Ray, Density, Sonic, Neutron,
Other (Describe) _____ *No Log Run*

Name of Organization Running Log

SCREEN DATA

Diameter - Inches	Length - Feet	Slot Size - Inches
Screen Type	Depth to Bottom - Feet	

GEOLOGIC DATA (Office Use Only)

Surface Elev.	Geologic Unit	Unit Thickness	Depth to Top
Subs. SWL	Date	Analysis	Aquifer Test

Driller's Remarks
Spelled 4 1/2" test hole 540 feet

DESCRIPTION OF FORMATIONS ENCOUNTERED	FROM	TO	FORMATIONS (Continued)	FROM	TO
<i>Surface</i>	<i>0</i>	<i>12</i>			
<i>Runer Bottom Sand</i>	<i>12</i>	<i>3.5</i>			
<i>Gray Clay</i>	<i>35</i>	<i>160</i>			
<i>Money Branch</i>	<i>160</i>	<i>190</i>			
<i>Sandy shale lignite</i>	<i>190</i>	<i>300</i>			
<i>fine sand</i>	<i>300</i>	<i>540</i>			

RECEIVED


JUL 20 1990

Department of Natural Resources
Bureau of Land & Water Resources

IF MORE SPACE IS NEEDED, USE BACK

If well telescopes please sketch and show depths.

GROUND LEVEL

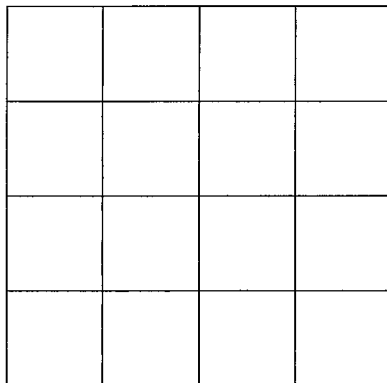

SECTION _____

Please indicate well location X.

ADDITIONAL INFORMATION

If more than one screen,
show location of each on sketch.