

ELOG# 168

MISSISSIPPI
BOARD OF WATER COMMISSIONERS
416 North State Street
Jackson, Mississippi 39201

CODED

WATER WELL DRILLERS LOG

MADISON
K10
2-68
USGS

2-13 1968 Truel Drilling Madison
date well completed firm name county well located

LANDOWNERS: Truel Drilling Center
State of Miss.
Jackson, Miss.
(mailing address)

description of formations encountered	from	to
Brn. Silt + Yel. clay	35	
Blue Clay	223	
Yel. Clay + Silt	295	
med sand	326	
Shale	339	
Silt, Sand + Shale	405	
Silt + Silt Shale	465	
F. Sand + Silt Clay	515	
Fine Sand	565	
F. Sand + Silt Shale	585	
Sand + Shale	605	
Fine Sand	630	
Shale	704	
Silt + Shale	718	
Shale	790	
Silt + Silt Clay	811	
Shale	815	
Silt Shale	874	
Silt + Shale	895	
Hard Shale	958	
Shale + Silt	1004	
Fine Sand	1020	
Shale	1024	
Fine Sand	1062	
Med Sand	1105	


WELL LOCATION:
sec. 22 T. 9N R. 1W
S E W
Hera
miles of (nearest town)

WELL PURPOSE:
(home, irrigation, municipal, industrial)

WELL COMPLETION DATA:

- (1) diameter (inches) 4" x 2 1/2"
- (2) total depth (feet) 1105 ft
- (3) static water level (feet) 85' below top of ground.
- (4) casing 4" Blk pipe (material) 753 ft (depth)
- (5) screen 25 ft (length) 1080 (depth to top)
- (6) pump (HP) (yield gpm)
- (7) electric log yes (yes or no)
- (8) how well bottom plugged

DRILLERS REMARKS:

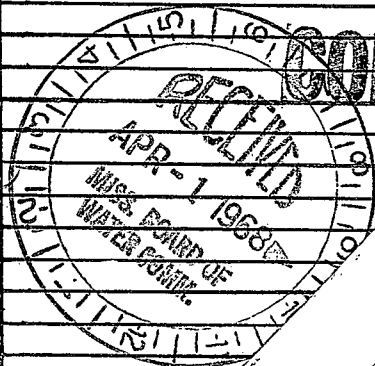


CODED

NOV 1968

If well telescopes please sketch and show depths.

SW/4
SE/4
NW/4

GROUND LEVEL

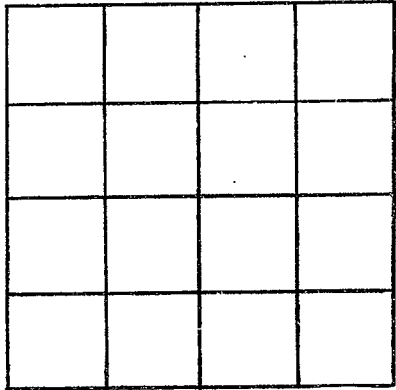

SECTION 22

Please indicate well location X.

ADDITIONAL INFORMATION

A series of horizontal lines for recording additional information, starting below the 'ADDITIONAL INFORMATION' header.

If more than one screen, indicate locations of each on sketch.