

MADISON
K12
4-20-71

MISSISSIPPI
 BOARD OF WATER COMMISSIONERS
 416 North State Street
 Jackson, Mississippi 39201

CODED

WATER WELL DRILLERS LOG

April 20 1971 E.M. "Bud" Cresswell Madison
 date well completed firm name county well located

LANDOWNER:
Madison Livestock Co.
FLORA, Miss.
 (mailing address)

description of formations encountered	from	to
<u>Clay - yellow</u>	<u>0</u>	<u>60</u>
<u>Clay & blue</u>	<u>60</u>	<u>340</u>
<u>Sandy shale</u>	<u>340</u>	<u>520</u>
<u>Sand</u>	<u>520</u>	<u>620</u>

WELL LOCATION:
 sec 31 T 9 N R 1 E
 & W
3 miles North of FLORA
 (distance) (direction) (nearest town)

WELL PURPOSE: Domestic
 (home, irrigation, municipal, industrial)

WELL COMPLETION DATA:
 (1) diameter (inches) 4" x 2"
 (2) total depth (feet) 620
 (3) static water level (feet) 120 below above top of ground.
 (4) casing steel 315
 (material) (depth)
4 if telescope see back.
 (size)
 (5) screen 20 ft 600 ft
 (length) (depth to top)
2 stainless
 (size) (material)
 (6) pump 1 10
 (HP) (yield gpm)
0
 (type power)
 (7) electric log No
 (yes or no)
 (organization running log)

CODED


MAY 20 1971

MISSISSIPPI
 BOARD OF
 WATER COMMISSIONERS

(8) how well bottom plugged steel plug
 DRILLERS REMARKS:

If well telescopes please sketch and show depths.

GROUND LEVEL

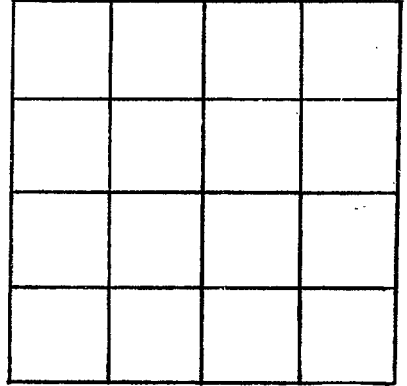

SECTION _____

Please indicate well location X.

ADDITIONAL INFORMATION

If more than one screen,
show locations of each on sketch.