

MADISON
K 16
4-25-74

MISSISSIPPI
BOARD OF WATER COMMISSIONERS
416 North State Street
Jackson, Mississippi 39201

CODED

WATER WELL DRILLERS LOG

April 25 1974 E.M. "Bud" CRESSWELL Madison
date well completed firm name county well located

LANDOWNER:
L. V. Sumler
Flora, Miss.
(mailing address)

description of formations encountered	from	to
	Clay silt	0
	320	440

WELL LOCATION:
sec. 33 T 9 N R 1 E
S W
2 miles North of Flora
(distance) (direction) (nearest town)

WELL PURPOSE: Home
(home, irrigation, municipal, industrial)

- WELL COMPLETION DATA:
- (1) diameter (inches) 2
 - (2) total depth (feet) 440
 - (3) static water level (feet) 80 below top of ground.
 - (4) casing steel, 420 (material), (depth)
2 (size) If telescope see back.
 - (5) screen 20, 420 (length), (depth to top)
2 (size), Stainless (material)
 - (6) pump Air compressor (HP) (yield gpm)
0 (type power)
 - (7) electric log No (yes or no)
0 (organization running log)
 - (8) how well bottom plugged Plug Plug

CODED


DRILLERS REMARKS:

RECORDED
MAY 21 1974

MISS. BD. OF WATER COMMISSIONERS

If well telescopes please
sketch and show depths.

GROUND LEVEL

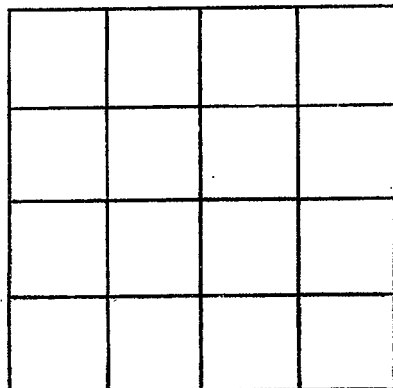

SECTION _____

Please indicate well location X.

ADDITIONAL INFORMATION

If more than one screen,
show locations of each on sketch.