

Madison  
K17  
10/5/80

MISSISSIPPI  
BOARD OF WATER COMMISSIONERS  
416 North State Street  
Jackson, Mississippi 39201

CODED

WATER WELL DRILLERS LOG

*Shiner Drilling Service, Inc*

*Madison*

10-5-80  
date well completed

firm name

county well located

LANDOWNER:

*Texas Crude, Inc.  
700 National Gas Bld.  
1200 Travis St.  
Houston (mailing address) 77002*

description of formations encountered

from to

WELL LOCATION: *NE NW*  
*25 T 9 N R 1 E*  
*Flora*  
*2.5* miles (distance) of (direction) (nearest town)

<i>clay</i>	<i>0</i>	<i>525</i>
<i>clay, sand</i>	<i>525</i>	<i>650</i>
<i>clay</i>	<i>650</i>	<i>930</i>
<i>sand</i>	<i>930</i>	<i>1000</i>
<i>clay</i>	<i>1000</i>	<i>1008</i>

WELL PURPOSE: *oil field*  
(home, irrigation, municipal, industrial)

WELL COMPLETION DATA:

- (1) diameter (inches) *3"*
- (2) total depth (feet) *1008'*
- (3) static water level (feet) *75' below*  
top of ground.
- (4) casing *steel, 980'*  
(material) (depth)  
*3"*  
(size) if telescope see back.
- (5) screen *42', 938'*  
(length) (depth to top)  
*3", perforated*  
(size) (material)
- (6) pump *75 to 100*  
(HP) (yield gpm)
- ac*  
(type power)
- (7) electric log \_\_\_\_\_  
(yes or no)

(organization running log)

(8) how well bottom plugged *orange peel*

DRILLERS REMARKS:


DEPT. OF NATURAL RESOURCES  
BUREAU OF LAND & WATER RESOURCES

OCT 23 1980

RECEIVED

If well telescopes please sketch and show depths.

GROUND LEVEL

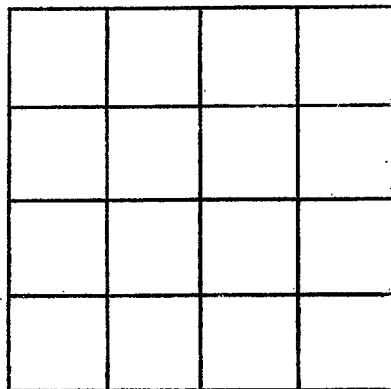

SECTION \_\_\_\_\_

Please indicate well location X.

ADDITIONAL INFORMATION

If more than one screen,  
show locations of each on sketch.