

MADISON
K-18
12-31-80
Dec. 31

MISSISSIPPI
BOARD OF WATER COMMISSIONERS
416 North State Street
Jackson, Mississippi 39201

CODED

WATER WELL DRILLERS LOG

1980 R. M. "Bud" CRESSWELL Madison
date well completed firm name county well located

LANDOWNER:
Mrs. F. C. Tyner
CANTON, MS.
(mailing address)

description of formations encountered	from	to
Clay	0	30
Bank -	30	55
Clay	55	330
Bank. shale	330	480
Sand	480	580

WELL LOCATION:
sec. 12 T 9 N R 1 W
7 miles N.E. of FLORA
(distance) (direction) (nearest town)

WELL PURPOSE: Home
(home, irrigation, municipal, industrial)

- WELL COMPLETION DATA:
- (1) diameter (inches) 2
 - (2) total depth (feet) 580
 - (3) static water level (feet) 85 below above top of ground.
 - (4) casing Steel 560
(material) (depth)
2 (size) if telescope see back.
 - (5) screen 20 560
(length) (depth to top)
2 STAINLESS
(size) (material)
 - (6) pump Air Compressor
(HP) (yield gpm)
 - (type power)
 - (7) electric log No
(yes or no)
 - (organization running log)
 - (8) how well bottom plugged
Sand Plug

DRILLERS REMARKS:


DEPT. OF NATURAL RESOURCES
BUREAU OF LAND & WATER RESOURCES

JAN 22 1981

RECEIVED

If well telescopes please
sketch and show depths.

GROUND LEVEL

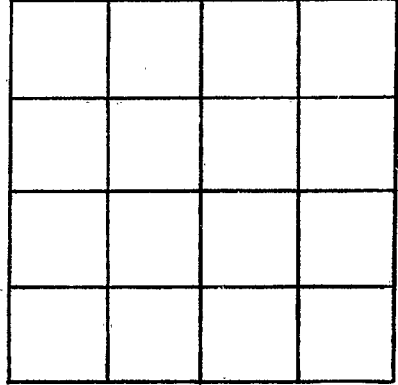

SECTION _____

Please indicate well location X.

ADDITIONAL INFORMATION

If more than one screen,
show locations of each on sketch.