

MISSISSIPPI DEPARTMENT OF NATURAL RESOURCES

Bureau of Land and Water Resources

Southport Mall

P.O. Box 10631

Jackson, Mississippi 39209

WATER WELL DRILLERS LOG

CODED

Madison
K 19
9-19-81

Gunter Drilling Service, Inc.

Madison

9-19-81 date well completed

firm name

county well located

LANDOWNER:

Omni Exploration
One Canal Plaza
Suite 2726
New Orleans, La. 70130
(mailing address)

description of formations encountered

from

to

chalk

0 210

sand, chalk

210 273

chalk

273 504

sand

CODED

504 567

WELL LOCATION: 1900'S & 814'E of

sec. 23 T. 9 R. 1 E NW/4
No. 1 Parkman's Estate
et al miles from
(distance) (direction) (nearest town)

WELL PURPOSE: oil field
(home, irrigation, municipal, industrial)

WELL COMPLETION DATA:

- (1) diameter (inches) 3"
- (2) total depth (feet) 567'
- (3) static water level (feet) 75' below top of ground.
- (4) casing steel 567' (material) (depth)
3" (size) if telescope see back.
- (5) screen 42' 525' (length) (depth to top)
3" perforated (size) (material)
- (6) pump — 75 (HP) (yield gpm)
ac (type power)
- (7) electric log — (yes or no)
— (organization running log)

(8) how well bottom plugged orange
peel


DRILLERS REMARKS:

DEPT. OF NATURAL RESOURCES
BUREAU OF LAND & WATER RESOURCES

SEP 28 1981
RECEIVED

If well telescopes please sketch and show depths.

GROUND LEVEL

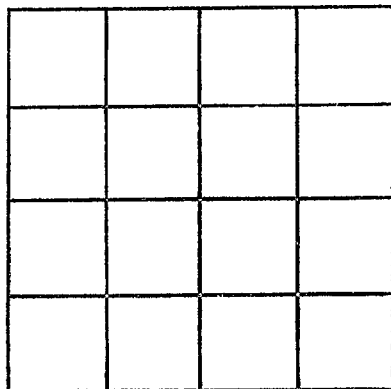

SECTION _____

Please indicate well location X.

ADDITIONAL INFORMATION

If more than one screen, show locations of each on sketch.