

MISSISSIPPI DEPARTMENT OF NATURAL RESOURCES

Bureau of Land and Water Resources

Southport Mall

P.O. Box 10631

Jackson, Mississippi 39209

WATER WELL DRILLERS LOG

MADISON
K21
5/15/84

6W-1146

186'

NE 1/4 21

May 1984
date well completed

84 Herndon Wells Supply Inc
firm name

Madison
county well located

LANDOWNER: Kearney Park
Land Company
P.O. Box 22511
Jackson, MS 39205
(mailing address)

description of formations encountered	CODED	from	to
Brown Sand		0	20
Green Clay		20	200
Silty Clay	CODED	200	240
Brown Silty Sand		240	440
Dark Sand		440	460
Fine Brown Sand		460	600
Sand with Lignite		600	620
Clay		620	800
Grey Sand		800	820
Clay		820	840
Silty Sand		840	860
Brown Sand		860	920
Silty Sand		920	980
Dark Sand		980	1080
Sand + Clay		1080	1100
Grey Sand		1100	1160
Clay		1160	1200
Silty Sand		1200	1220
Silty Sand		1220	1260
Dark Sand		1260	1320

WELL LOCATION: Well # 2
sec 21 T 9N R 1E
S W
2 miles NE of Blount
(distance) (direction) (nearest town)

WELL PURPOSE: Industrial
(home, irrigation, municipal, industrial)

- WELL COMPLETION DATA:
- (1) diameter (inches) 12
 - (2) total depth (feet) 1155
 - (3) static water level (feet) 85 below above top of ground.
 - (4) casing Steel, 980' (material) (depth)
(size) If telescope see back.
 - (5) screen 100' (length) (depth to top)
8" (size) Steel (material)
 - (6) pump 80 (HP) 1500 (yield gpm)
Diesel (type power)
 - (7) electric log Yes (yes or no)
Bureau of Geology (organization running log)
 - (8) how well bottom plugged Lockwell
Valve

DEPT OF NATURAL RESOURCES
BUREAU OF LAND & WATER RESOURCES

SEP 26 1984


RECEIVED

DRILLERS REMARKS:

(X)

If well telescopes please sketch and show depths.

GROUND LEVEL

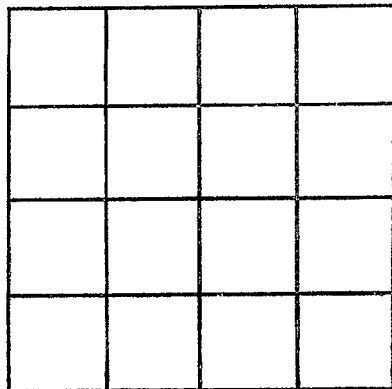

SECTION _____

Please indicate well location X.

ADDITIONAL INFORMATION

If more than one screen,
show locations of each on sketch.