

Madison  
K 23  
4-30-85

MISSISSIPPI  
 BOARD OF WATER COMMISSIONERS  
 416 North State Street  
 Jackson, Mississippi 39201

CODED

WATER WELL DRILLERS LOG  
 TOM GRIFFITH

4/30 19 85 PLUMBING & WELL SERVICE INC. Madison  
 date well completed firm name county well located


LANDOWNER: <u>David + New</u>	description of formations encountered	from	to
<u>P.O. Box 1487</u>			
<u>Natchez, MS 39120</u> (mailing address)	<u>clay</u>	<u>1</u>	<u>28</u>
	<u>sand</u>	<u>28</u>	<u>35</u>
	<u>clay</u>	<u>35</u>	<u>200</u>
	<u>sand</u>	<u>200</u>	<u>265</u>
	<u>clay</u>	<u>265</u>	<u>380</u>
	<u>sand</u>	<u>380</u>	<u>500</u>
WELL LOCATION: <u>sec 13 T 8 N R 1 W</u> <u>9 miles SW of Canton</u> (distance) (direction) (nearest town)			
WELL PURPOSE: <u>oil loc.</u> (home, irrigation, municipal, industrial)			
WELL COMPLETION DATA:			
(1) diameter (inches) <u>3"</u>			
(2) total depth (feet) <u>500'</u>			
(3) static water level (feet) <u>60</u> <sup>below</sup> <sub>above</sub> top of ground.			
(4) casing <u>PVC</u> , <u>420</u> , (material) (depth) <u>n/a</u> if telescope see back. (size)	<u>#1 Howard 15-13</u>		
(5) screen <u>80'</u> , <u>420</u> (length) (depth to top) <u>3"</u> , <u>PVC .030</u> (size) (material)	<u>990' N + 1250' E of</u> <u>SW COR SEC 13-9N-1W</u>		
(6) pump <u>air lift</u> , <u>70</u> (HP) (yield gpm) <u>diesel</u> (type power)			
(7) electric log <u>no</u> (yes or no) <u>n/a</u> (organization running log)			
(8) how well bottom plugged <u>BCW</u>			
DRILLERS REMARKS:			

RECEIVED  
 NOV 20 1985

Department of Natural Resources  
 Bureau of Land & Water Resources

If well telescopes please sketch and show depths.

GROUND LEVEL

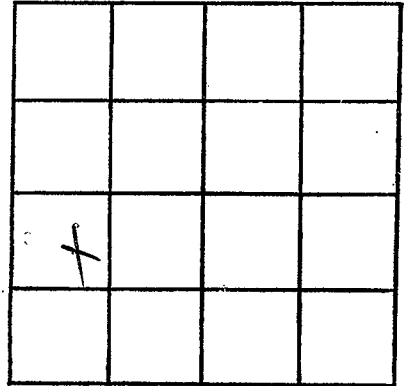

SECTION \_\_\_\_\_

Please indicate well location X.

ADDITIONAL INFORMATION

If more than one screen,  
show locations of each on sketch.