

MADISON
K 2A
6-10-85

MISSISSIPPI
BOARD OF WATER COMMISSIONERS
416 North State Street
Jackson, Mississippi 39201

CODED

WATER WELL DRILLERS LOG


TOM GRIFFITH

6-10 19 85 date well completed
PLUMBING & WELL SERVICE, INC. firm name
Madison county well located

LANDOWNER: David New	description of formations encountered		from	to
PO Box 1487	Clay		1	200
Natchez, MS 39120 (mailing address)	Sand		200	240
WELL LOCATION:	Clay		240	300
sec 13 T 9 N R 1 E S W	Sand		300	320
9 miles NW of Canton (distance) (direction) (nearest town)	Clay		320	520
WELL PURPOSE: (home, irrigation, municipal, industrial)	Sand		520	580
WELL COMPLETION DATA:				
(1) diameter (inches) 3"	#2 Howard 13-13			
(2) total depth (feet) 580	770' N + 100' E of			
(3) static water level (feet) 70' below top of ground.	SW/COZ Sec 13-9N-1W			
(4) casing PVC, 520' (material) (depth)				
n/a if telescope see back. (size)				
(5) screen 60', 520' (length) (depth to top)				
3" PVC (size) (material)				
(6) pump air lift 70 (HPY) (yield gpm)				
deisel (type power)				
(7) electric log n/a (yes or no)				
n/a (organization running log)				
(8) how well bottom plugged 1300V				
DRILLERS REMARKS:				

If well telescopes please sketch and show depths.

GROUND LEVEL

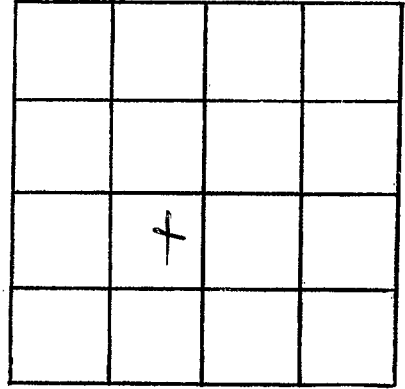

SECTION _____

Please indicate well location X.

ADDITIONAL INFORMATION

If more than one screen,
show locations of each on sketch.