

MISSISSIPPI DEPARTMENT OF NATURAL RESOURCES

Bureau of Land and Water Resources

Southport Mall

P.O. Box 10631

Jackson, Mississippi 39209

WATER WELL DRILLERS LOG

MADISON  
K 27  
5/12/88

Used

MAY 12 1988 E.M. Bud Cresswell MADISON  
date well completed firm name county well located

LANDOWNER:	description of formations encountered	from	to
<u>Reed Lacy</u>	<u>Yellow clay</u>	<u>0</u>	<u>40</u>
<u>FLORA, MS.</u> (mailing address)	<u>blue clay</u>	<u>40</u>	<u>250</u>
WELL LOCATION: sec. <u>27</u> T <u>9</u> N R <u>1</u> W <u>3</u> miles <u>North</u> of <u>FLORA</u> (distance) (direction) (nearest town)	<u>Sand-on shale</u>	<u>250</u>	<u>275</u>
WELL PURPOSE: <u>Home</u> (home, irrigation, municipal, industrial)	<u>Sandy shale</u>	<u>275</u>	<u>600</u>
WELL COMPLETION DATA: (1) diameter (inches) <u>4</u>	<u>Sand / shale</u>	<u>600</u>	<u>640</u>
(2) total depth (feet) <u>1100</u>	<u>shale - tough</u>	<u>640</u>	<u>760</u>
(3) static water level (feet) <u>140</u> below top of ground.	<u>shale - trash</u>	<u>760</u>	<u>820</u>
(4) casing <u>Steel</u> / <u>1060</u> (material) (depth)	<u>Sand - shale shale</u>	<u>820</u>	<u>840</u>
<u>4</u> (size) if telescope see back.	<u>Sandy shale</u>	<u>840</u>	<u>900</u>
(5) screen <u>40</u> / <u>1060</u> (length) (depth to top)	<u>Sand / fine</u>	<u>900</u>	<u>1000</u>
<u>2</u> (size) / <u>STAINLESS</u> (material)	<u>Sand / good</u>	<u>1000</u>	<u>1040</u>
(6) pump <u>5</u> / <u>50</u> (HP) (yield gpm)	<u>Sand / fine</u>	<u>1040</u>	<u>1100</u>
(type power)			
(7) electric log <u>Yes</u> (yes or no)			
<u>State</u> (organization running log)			
(8) how well bottom plugged <u>Sand / shale</u>			

RECEIVED


MAY 31 1988

Department of Natural Resources  
Bureau of Land & Water Resources

DRILLERS REMARKS:

If well telescopes please sketch and show depths.

GROUND LEVEL

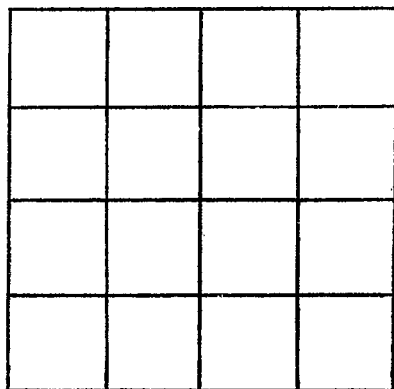

SECTION \_\_\_\_\_

Please indicate well location X.

ADDITIONAL INFORMATION

If more than one screen,  
show locations of each on sketch.