

ALREADY CORRECT

MISSISSIPPI DEPARTMENT OF NATURAL RESOURCES
Bureau of Land and Water Resources

P.O. Box 10631

Jackson, Mississippi 39209

WATER WELL DRILLERS LOG

COUNTY WELL LOCATED
MADISON

WELL NUMBER **189770** CODED

K 31

DATE WELL COMPLETED
3-01-93

PERMIT NUMBER
510

NAME OF DRILLING FIRM
EASLEY Water Well
Brookhaven, MS 39601

NAME & MAILING ADDRESS OF LANDOWNER
Robert Goff

WELL LOCATION: SEC **23** TOWNSHIP **9** RANGE **1**

DISTANCE _____ MILES _____ OF _____

DIRECTION _____ NEAREST TOWN _____

OTHER LANDMARK _____

WELL PURPOSE: Home, Irrigation, Municipal, Industrial, Fish Pond, etc.

PUMP DATA

PUMP TYPE (Circle One):
Submersible, Turbine, Jet, Flowing Well,
Other (Describe) **1HP**

POWER TYPE (Circle One):
Electric, Tractor, Diesel, Gasoline, Butane,
Other (Describe) _____

Pump Capacity (GPM) **106GPM** No. of Stages _____ Setting Depth _____ FT.

PUMP TEST

Well yielded _____ GPM with
a drawdown of _____ ft.
after _____ hours of pumping

WELL DATA

Well Depth **640'** Casing Diameter (In.) **4"** Casing Length (Ft.) **620'**

Type of Casing **PVC** Hole Depth **700'** Depth to Static Water Level _____

TYPE OF COMPLETION: (Circle One or More):
Gravel Packed, Underreamed, Telescoped,
Natural Development, Open Hole, Other
(Describe) **Home**

Top of Lap Pipe or Reduction in Casing _____

FEET IF TELESCOPED OR MORE THAN ONE SCREEN: USE BACK PAGE

LOG DATA

TYPE OF LOG RUN (Circle One):
No Log Run, Electric, Gamma Ray, Density, Sonic, Neutron,
Other (Describe) _____

Name of Organization Running Log. _____

SCREEN DATA

Diameter - Inches **4** Length - Feet **20'** Slot Size - Inches **#8**

Screen Type **PVC** Depth to Bottom - Feet **700'**


GEOLOGIC DATA (Office Use Only)

Surface Elev.	Geologic Unit	Unit Thickness	Depth to Top
Subs. SWL	Date	Analysis	Aquifer Test

Driller's Remarks

DESCRIPTION OF FORMATIONS ENCOUNTERED	FROM	TO	FORMATIONS (Continued) FROM	TO
CLAY	0	80		
Shells + SAND	80	90		
CLAY	90	60		
SAND	610	670		
CLAY	670	700		

IF MORE SPACE IS NEEDED, USE BACK

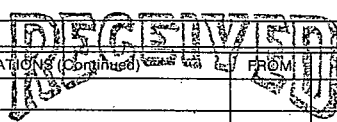


JUL 05 1993

Dept. of Environmental Quality
Office of Land & Water Resources

If well telescopes please
sketch and show depths.

GROUND LEVEL

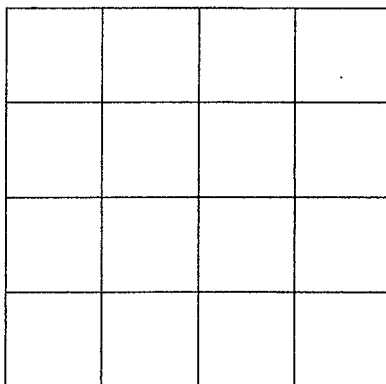

SECTION _____

Please indicate well location X.

ADDITIONAL INFORMATION

If more than one screen,
show location of each on sketch.