

MADISON

K

2001

4-24-78

MISSISSIPPI BOARD OF WATER COMMISSIONERS
416 North State Street
Jackson, Mississippi 39201

WATER WELL DRILLERS LOG

4-24
date well completed

1978 E.M. "Bud" Cresswell
firm name

MADISON
county well located

LANDOWNER:

Robert Craft

Flora, MS.

(mailing address)

description of formations encountered

from

to

Clay
sand

0 20
20 45

WELL LOCATION:

sec. 14 T 9 N R 1 E
5 miles North of Flora
(distance) (direction) (nearest town)

WELL PURPOSE: home
(home, irrigation, municipal, industrial)

WELL COMPLETION DATA:

- (1) diameter (inches) 2
- (2) total depth (feet) 45
- (3) static water level (feet) 10 below above top of ground.
- (4) casing PVC 40
(material) (depth)
2 (size) if telescope see back.
- (5) screen 5 40
(length) (depth to top)
2 PVC
(size) (material)
- (6) pump 1 12
(HP) (yield gpm)
0
- (7) electric log No
(yes or no)
- (organization running log)

(8) flow well bottom plugged
back wash valve


DRILLERS REMARKS:

RECEIVED
MAY 3 - 1978

MISS. BD. OF WATER COMMISSIONERS

If well telescopes please
sketch and show depths.

GROUND LEVEL

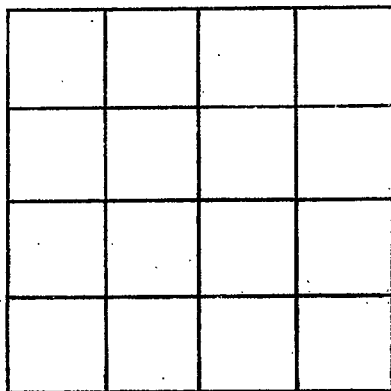

SECTION _____

Please indicate well location X.

ADDITIONAL INFORMATION

If more than one screen,
show locations of each on sketch.