

MADISON MISSISSIPPI BOARD OF WATER COMMISSIONERS

L  
10-21-65

WATER WELL DRILLERS LOG

Date: 10/21, 1965, Driller: Forest Drilling Co. Madison  
(Name)

Joe HARRY JR

(1) Owner of Land:	(Name)	Description & Color of Materials Sand, Clay, Red Clay, Shell etc.	Thick- ness Feet	Depth Feet
E. L. Conrad	Construction	Brown silt		8
Carnton	Miss	yellow clay		47
	(Address)	blue clay		184
(2) Location: 1/4, 1/4, Sec. 21 T. 9 R. 2E		shale		215
11 miles West of Carnton	(distance) (direction) (Nearest Town)	kenne + sandy shale		246
(3) Topography: <input checked="" type="checkbox"/> (Level)		shale + silt silt		266
(4) Purpose of Well: Home	(Domestic Irrigation, Municipal, Industrial, Other)	shale		320
		silt + silt shale		328
		fine sand		372


Information upon completion of well:

- (1) Diameter 7 inches.
- (2) Total Depth 372 feet.
- (3) Water Level 44 feet below top of ground.
- (4) Cased to 357, Size 2"
- (5) Screen: Size 2", Length 15ft.
- (6) Were any formations sealed against pollution?  
yes,  no.

If YES depth of formation \_\_\_\_\_

Why \_\_\_\_\_

Drillers Remarks: \_\_\_\_\_

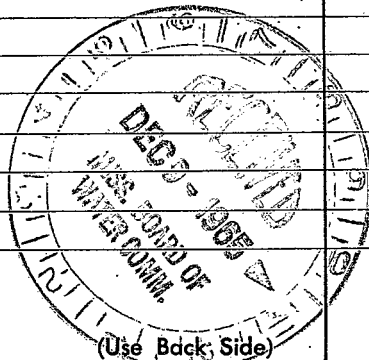

Well No.

