

L 10
10-4-62

WATER WELL DRILLERS LOG

CODED

Date: Oct 4, 1962, Driller: M^c Kay County: Madison
(Name)

- (1) Owner of Land: A B. Crawford
(Name)
Flora mini
(Address)
- (2) Location: 1/4, 1/4, Sec. 19
20
29 T9 R1E,
10 miles West of Center
(distance) (direction) (Nearest Town)
- (3) Topography: —
(Hilly) (Flat) (Level)
- (4) Purpose of Well: Home
(Domestic Irrigation
Municipal, Industrial, Other)

Description & Color of Materials Sand, Clay, Red Clay, Shell, etc.	Thick- ness Feet	Depth Feet
<u>White Clay</u>	<u>0</u>	<u>21</u>
<u>Blue clay</u>	<u>21</u>	<u>42</u>
<u>Blue clay</u>	<u>42</u>	<u>63</u>
<u>Blue clay</u>	<u>63</u>	<u>252</u>
<u>woody brick</u>	<u>252</u>	<u>273</u>
<u>Rock</u>	<u>273</u>	<u>273 1/2</u>
<u>woody brick sand</u>	<u>273 1/2</u>	<u>315</u>
<u>Clay - Sand</u>	<u>315</u>	<u>334</u>
<u>Blue clay</u>	<u>333</u>	<u>378</u>
<u>Brown clay</u>	<u>378</u>	<u>462</u>
<u>Clay and Sand</u>	<u>462</u>	<u>483</u>
<u>Fine Sand</u>	<u>483</u>	<u>509</u>
<u>Med Sand</u>	<u>509</u>	<u>630</u>
<u>Set well at 630 ft</u>		
<u>Green Sand and clay</u>	<u>630</u>	<u>799</u>

Information upon completion of well:


- (1) Diameter 2 1/2 x 2 inches.
- (2) Total Depth 630 feet.
- (3) Water level 62 feet below top of ground.
- (4) Cased to _____, Size _____
- (5) Screen: Size 007, Length 20 ft.
- (6) Were any formations sealed against pollution?
_____ yes, no.

If YES depth of formation _____
Why _____

Drillers Remarks: _____

3 H.P. air unit.

CODED

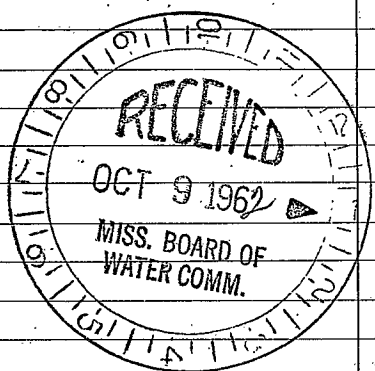

(Use Back Side)

Well No.

