

L 11

9-23-63

WATER WELL DRILLERS LOG

CODED

Date: 9/23, 1963, Driller: M. Kay County: Madison
(Name)

(1) Owner of Land: Alfred Hardy Jr.
(Name)
Canton, Miss.
(Address)

(2) Location: 1/4, 1/4, Sec. 17 T 9 R 1 E
12 miles W, of Canton
(distance) (direction) (Nearest Town)

(3) Topography: (Hilly) (Flat) (Level)

(4) Purpose of Well: (Domestic Irrigation) (Municipal, Industrial, Other)

Description & Color of Materials Sand, Clay, Red Clay, Shell, etc.	Thick- ness Feet	Depth Feet
yellow clay	0	21
Blue clay	21	42
Blue clay	42	210
Sandy clay - Fungite	210	252
Brown clay	252	294
Sandy clay	294	315
Fine sand	315	378
Sand - Clay Shale	378	399
Fine Sand	399	420
Med Sand	420	441
Med Sand	441	462

Information upon completion of well:

(1) Diameter 2 inches.

(2) Total Depth 462 feet.

(3) Water Level 89 feet below top of ground.

(4) Cased to _____, Size _____

(5) Screen: Size 007, Length 20

(6) Were any formations sealed against pollution?
 yes, no.


If YES depth of formation _____

Why _____

Drillers Remarks: _____

CODED

3 HP am mt.

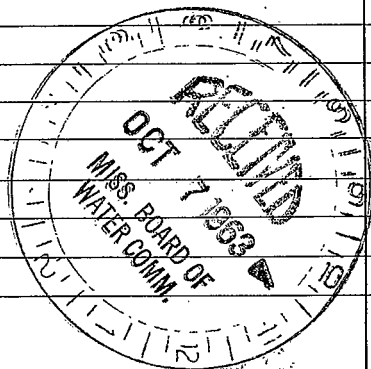

(Use Back Side)

Well No.

