

MADISON
L15

11-21-73

Log # 212

MISSISSIPPI
BOARD OF WATER COMMISSIONERS
416 North State Street
Jackson, Mississippi 39201

CODED

WATER WELL DRILLERS LOG

Nov. 21 1973 F.M. "Bud" Crosswell Madison
date well completed firm name county well located

LANDOWNER:

H.R. Tyner
CANTON, Miss.
(mailing address)

description of formations encountered

from to

CLAY	0	55
CLAY - Blue	55	175
sdyl shale	175	390
shale	390	440
Sdy shale	440	600
Shale STRAITS SAND	600	920
SAND	920	1040

WELL LOCATION:

sec. 8 T 9 N R 1 E
8 miles West of CANTON
(distance) (direction) (nearest town)

WELL PURPOSE: FARM
(home, irrigation, municipal, industrial)

WELL COMPLETION DATA:


- (1) diameter (inches) 4
- (2) total depth (feet) 1040
- (3) static water level (feet) 8.0 below top of ground
- (4) casing (material) Steel, (depth) 1000
(size) 2 if telescope see back.
- (5) screen (length) 40, (depth to top) 1000
(size) 2, (material) Stainless
- (6) pump (HP) 2, (yield gpm) 30
(type power) 0
- (7) electric log (yes or no) Yes
Miss. STATE G.S.
(organization running log)
- (8) how well bottom plugged
Steel plug

DRILLERS REMARKS:

11-21-73

If well telescopes please sketch and show depths.

GROUND LEVEL

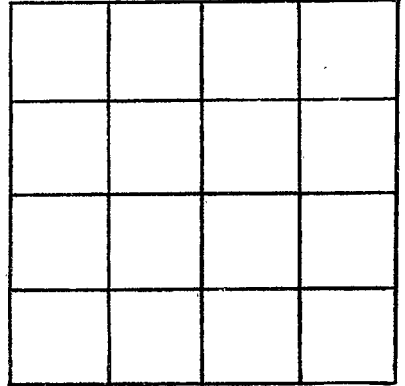

SECTION _____

Please indicate well location X.

ADDITIONAL INFORMATION

If more than one screen, show locations of each on sketch.