

MADISON

L 16

2-8-74

MISSISSIPPI BOARD OF WATER COMMISSIONERS
416 North State Street
Jackson, Mississippi 39201

WATER WELL DRILLERS LOG

CODED

Feb-8-

1974

John A Davis

MADISON

date well completed

firm name

county well located

LANDOWNER: EDMON JURNIA CH
RFD

description of formations encountered

from

to

Canton

(mailing address)

Red Clay

0

25

light clay

25

60

light blue

60

90

WELL LOCATION:

sec 29 T 9 N R 1 E
6 miles east of FLORA
(distance) (direction) (nearest town)

Blue Clay

90

210

WELL PURPOSE:

(home, irrigation, municipal, industrial)

Sand Strata

210

280

WELL COMPLETION DATA:

Fine Sand. Good

280

310

(1) diameter (inches) 2 1/2

(2) total depth (feet) 310

(3) static water level (feet) 80 below top of ground.

(4) casing PVC 290
(material) (depth)

2 1/2 If telescope see back.
(size)

(5) screen 20' 290
(length) (depth to top)

8 slot PVC
(size) (material)

(6) pump 2 22 P.M
(HP) (yield gpm)


Electrical
(type power)

(7) electric log ✓
(yes or no)

(organization running log)

(8) how well bottom plugged firm

CODED

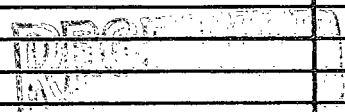


MAR 19 1974

DRILLERS REMARKS:

MISS. DEPT. OF WATER CONTROL

If well telescopes please sketch and show depths.

GROUND LEVEL

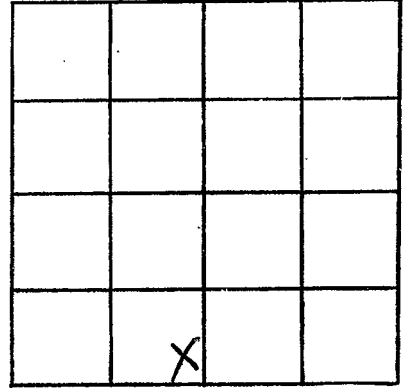

SECTION 29

Please indicate well location X.

ADDITIONAL INFORMATION

If more than one screen,
show locations of each on sketch.