

MADISON  
 L17  
 5-18-77  
 Flg# 242

MISSISSIPPI  
 BOARD OF WATER COMMISSIONERS  
 416 North State Street  
 Jackson, Mississippi 39201

CODED

WATER WELL DRILLERS LOG

May 18 1977 F.M. "Bud" CRESSWELL MADISON  
 date well completed firm name county well located

LANDOWNER:  
 H. B. Jordan Jr.  
 JACKSON, MS.  
 (mailing address)

description of formations encountered	from	to
Clay	0	20
Sand	20	45
Sandy Shale	45	340
Sand	340	430

WELL LOCATION:  
 sec. 4 T. 9 N. R. 1 E  
 5 miles West of CANTON  
 (distance) (direction) (nearest town)

CODED

WELL PURPOSE: Farm  
 (home, irrigation, municipal, industrial)

- WELL COMPLETION DATA:
- (1) diameter (inches) 4
  - (2) total depth (feet) 430
  - (3) static water level (feet) 60 below top of ground.
  - (4) casing PVC 410  
 (material) (depth)  
 4" if telescope see back.  
 (size)
  - (5) screen 20 410  
 (length) (depth to top)  
 4" PVC  
 (size) (material)
  - (6) pump 1 25  
 (HP) (yield gpm)  
 0 (type-power)
  - (7) electric log yes  
 (yes or no)  
 STATE  
 (organization running log)
  - (8) how well bottom plugged  
 Steel Plug


MISSISSIPPI  
 JUN 20 1977

DRILLERS REMARKS:

MISS. BO. OF WATER COMMISSIONERS

If well telescopes please sketch and show depths.

GROUND LEVEL

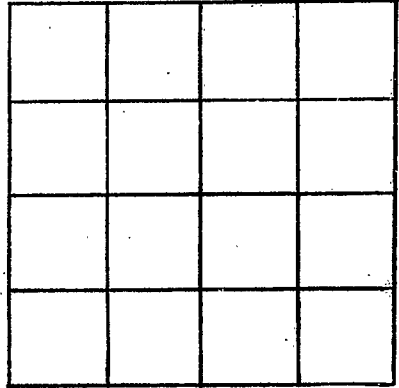

SECTION \_\_\_\_\_

Please indicate well location X.

ADDITIONAL INFORMATION

If more than one screen, show locations of each on sketch.