

CCKF

MADISON  
L 18  
11/19/77  
E log # 245

MISSISSIPPI  
BOARD OF WATER COMMISSIONERS  
416 North State Street  
Jackson, Mississippi 39201

CODED

WATER WELL DRILLERS LOG

11/19 1977 date well completed Jerry Quinn firm name Madison county well located

LANDOWNER: Harry Stewart  
Florea, Ms.  
(mailing address)

description of formations encountered	from	to
Clay	1	122
Sand & Shale	123	167
Clay	168	230
Sand & shale	231	400
Sand	401	506
Clay	506	525

WELL LOCATION:  
sec. 5 T 9 N R 1 E  
15 miles NE of Florea  
(distance) (direction) (nearest town)

WELL PURPOSE: Home  
(home, irrigation, municipal, industrial)

- WELL COMPLETION DATA:
- (1) diameter (inches) 4
  - (2) total depth (feet) 525
  - (3) static water level (feet) 68 below top of ground.
  - (4) casing PVC 420' (material) (depth)  
4" (size) if telescope see back.
  - (5) screen 30' 450' (length) (depth to top)  
4" (size) PVC (material)
  - (6) pump 2 25 (HP) (yield gpm)  
electricity (type power)
  - (7) electric log Yes (yes or no)  
Ms. Geological Survey (organization running log)
  - (8) how well bottom plugged

CODED  
(480 to 506 - Brown Sand)


RECEIVED  
NOV 25 1977

MISS. BD. OF WATER COMMISSIONERS

DRILLERS REMARKS:

If well telescopes please sketch and show depths.

GROUND LEVEL

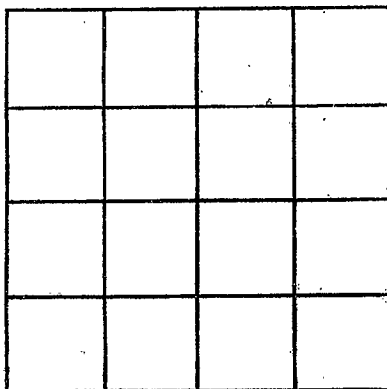

SECTION \_\_\_\_\_

Please indicate well location X.

ADDITIONAL INFORMATION

If more than one screen, show locations of each on sketch.