

MISSISSIPPI DEPARTMENT OF NATURAL RESOURCES
Bureau of Land and Water Resources
 Southport Mall
 P.O. Box 10631
 Jackson, Mississippi 39209
WATER WELL DRILLERS LOG

MADISON
L 24

12/14 19 86 Jerry Guinn Water Well Ser. Madison
 date well completed firm name county well located

LANDOWNER: Ray Tynor
Rt. 1 Box 100
CANTON, MS 39046
 (mailing address)

description of formations encountered	from	to
<u>14200 Clay</u>	<u>0</u>	<u>200</u>
<u>Sandy Shale</u>	<u>200</u>	<u>320</u>
<u>Clay</u>	<u>320</u>	<u>420</u>
<u>Sand</u>	<u>420</u>	<u>450</u>
<u>Sandy Shale</u>	<u>450</u>	<u>500</u>

WELL LOCATION:
 sec. 18 T. 9 N. R. 1 E
10 miles W of CANTON
 (distance) (direction) (nearest town)

WELL PURPOSE: None
 (home, irrigation, municipal, industrial)

- WELL COMPLETION DATA:**
- (1) diameter (inches) 4
 - (2) total depth (feet) 500
 - (3) static water level (feet) 120 below top of ground.
 - (4) casing PVC, 424,
 (material) (depth)
4" if telescope see back.
 (size)
 - (5) screen 20, 424
 (length) (depth to top)
4", PVC
 (size) (material)
 - (6) pump 1 1/2, 32
 (HP) (yield gpm)
electricity
 (type power)
 - (7) electric log Yes
 (yes or no)
Ms Bureau of Geology
 (organization running log)
 - (8) how well bottom plugged bracket sh valve

RECEIVED


FFB 03 1987

Department of Natural Resources
 Bureau of Land & Water Resources

DRILLERS REMARKS:

If well telescopes please sketch and show depths.

GROUND LEVEL

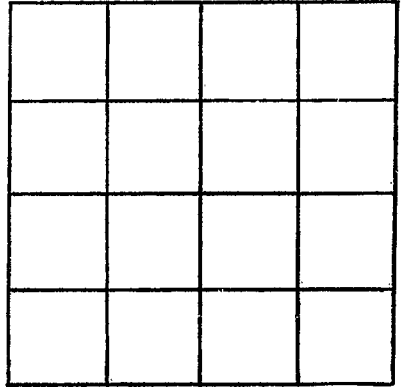

SECTION _____

Please indicate well location X.

ADDITIONAL INFORMATION

If more than one screen,
show locations of each on sketch.