

# STATE WELL REPORT

254

<b>Madison</b>
County: _____
Permit #: <u>Travis West</u>
Driller: _____ Date drilling completed: <u>6-13-2021</u>

**Part 1  
Driller's Log**

Mississippi Department of Environmental Quality  
Office of Land and Water Resources  
P.O. Box 2309  
Jackson, MS 39225-2309  
(601)961-5555  
(601)961-5228 (fax)

<b>For Office Use Only:</b>	
Well #: <u>L 38</u>	_____
Aquifer: _____	_____
E-Log #: _____	_____

*State Law requires that this report be prepared by the license holder responsible for the work and filed with the Department at the above address within 30 days of completion of drilling of the well or borehole.*

<p style="text-align: center;"><b>Well Owner Information</b> <i>(Landowner if borehole is not for a water well)</i></p> <p>Owner Name: <u>Chuck Bell</u></p> <p>Mailing Address: <u>541 Stokes Rd.</u></p> <hr/> <p>Flora MS 39071</p> <p>City State Zip Code</p> <p>Telephone No. (601) <u>831-2162</u></p>	<p style="text-align: center;"><b>Well or Borehole Location</b></p> <p>Latitude: <u>32.5792480</u> Longitude: <u>-90.2165696</u></p> <p>Method of Lat/Long (check one): Conventional Survey _____, Hand-held GPS <input checked="" type="checkbox"/>, Survey-grade GPS _____</p> <p>USGS quad <u>NW 1/4 SE 1/4, Sec 32 T 9N R 1E</u></p> <p><u>5.9</u> Miles <u>ENE</u> of <u>Flora</u></p> <p>(Distance) (Direction) (Nearest Town)</p>
--	--

<b>Well / Borehole Data</b>	
Date drilling started: <u>6-11-2021</u>	Date drilling completed: <u>6-13-2021</u> Hole depth: <u>545ft</u> Hole diameter: <u>6 1/2in</u>
Location of the source of any surface water used for drilling: <u>Lake on Property</u>	
Method of dosing and volume of Chlorine used in drilling and development: <u>Tab 50 PPM</u>	
Logs run (check all applicable): <input checked="" type="checkbox"/> log run <input type="checkbox"/> Electric <input type="checkbox"/> Gamma Ray <input type="checkbox"/> Density <input type="checkbox"/> Sonic <input type="checkbox"/> Neutron Other: _____	
Name of organization running log(s): _____	
Purpose of borehole (check one): Water Well <input checked="" type="checkbox"/> Geotechnical/Geological Investigation <input type="checkbox"/> Ground Source Heat Pump <input type="checkbox"/> Seismic Survey <input type="checkbox"/> Other (describe) _____	
<i>If drilling is not related to water well construction, skip the remainder of this block</i>	
Purpose of Well (check all applicable): <input checked="" type="checkbox"/> Home <input type="checkbox"/> Industrial <input type="checkbox"/> Public Supply <input type="checkbox"/> Irrigation <input type="checkbox"/> Fish Culture	
Other (describe): _____	
If a flowing well, method of flow regulation: Valve _____ Other (describe) _____	
Static Water Level: <u>116</u> feet <input type="checkbox"/> above or <input checked="" type="checkbox"/> below land surface (check one) Date measured: <u>6-13-2021</u>	
Method of measurement (check one) <input type="checkbox"/> Steel tape <input type="checkbox"/> Electric tape <input type="checkbox"/> Air line <input type="checkbox"/> Other (describe): <u>Sonar</u>	
Well depth: <u>545</u> feet Well grouted to a depth of: <u>40</u> feet Type of grout (check one) <input type="checkbox"/> Neat Cement <input type="checkbox"/> Bentonite <input checked="" type="checkbox"/> Mix	
Casing length: <u>505</u> feet Casing diameter: <u>4</u> inches Type of casing: <u>PVC</u>	
Screen length: <u>40</u> feet Screen diameter: <u>4</u> inches Type of screen: <u>PVC</u>	
Screen slot size: <u>.008</u> inches Setting depth: From <u>505</u> feet to <u>545</u> feet	
Type of completion (check all applicable) <input checked="" type="checkbox"/> gravel packed <input type="checkbox"/> Underreamed <input type="checkbox"/> Open hole <input type="checkbox"/> Natural Development	
Other (describe): _____	
Top of lap pipe or reduction in casing: _____ feet	
<i>If telescoped or more than one screen, describe on next page</i>	


RECEIVED  
JUL 16 2021  
BY OLWR

County: Madison  
 Permit #: \_\_\_\_\_

**For Office Use Only:**  
 Well #: \_\_\_\_\_

The sketch below only required for water wells


If well telescopes, show depths on sketch.

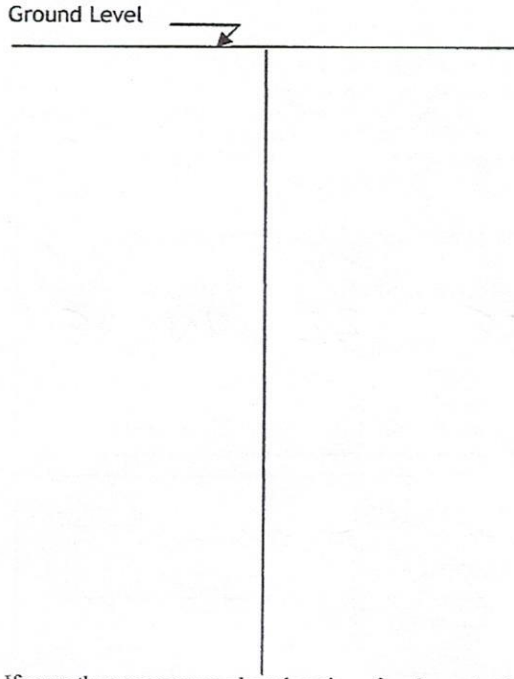


Description of formations encountered must be provided for all wells and boreholes, unless specifically exempted by regulations

Description of Formations Encountered	From (depth) Ground level	To (depth)
Clay	0	230
Moodys	230	260
Sandy	260	380
Sand	380	545

If more than one screen, show location of each on sketch

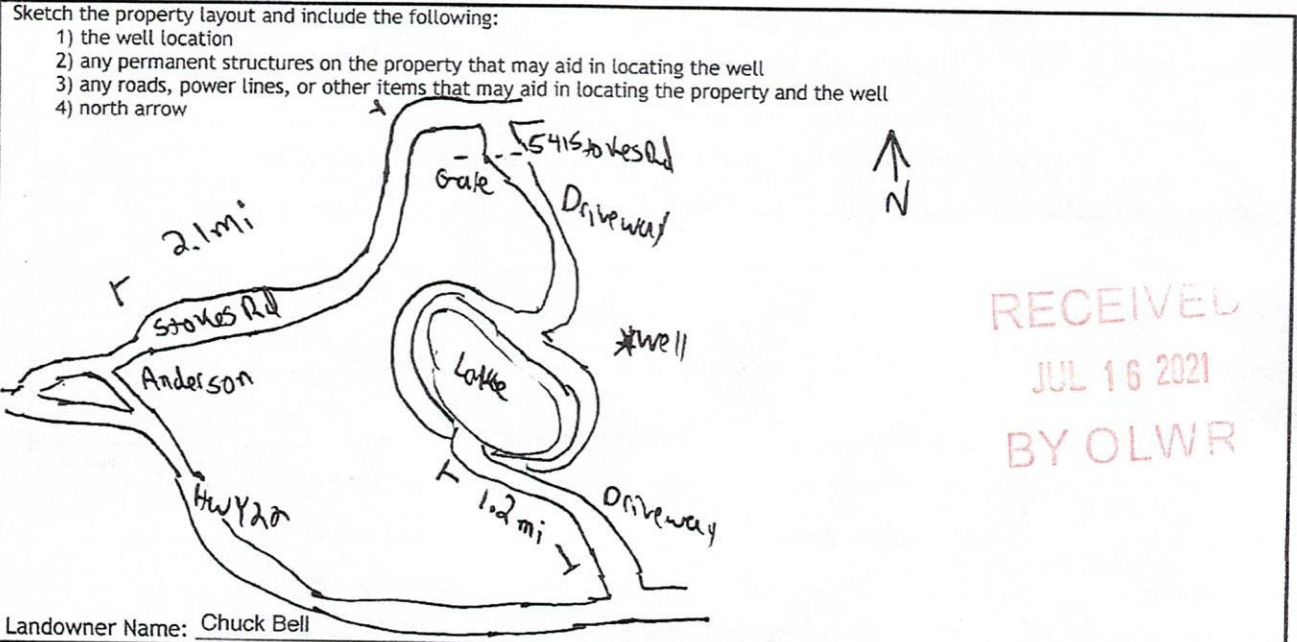

I HEREBY CERTIFY that the well/borehole was drilled, constructed, and completed in accordance with all applicable requirements of the Mississippi Department of Environmental Quality and the Mississippi Department of Health regulations, if applicable, and state laws.

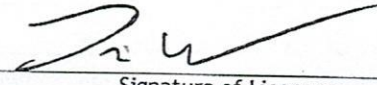Travis West UNR-00010622                      7-5-2021                        
 Print Name of Responsible Licensee and License No.                      Date                      Signature of Licensee



# STATE WELL REPORT

## Part 2

**Pump Installer's Completion Report**  
 Mississippi Department of Environmental Quality  
 Office of Land and Water Resources  
 P.O. Box 2309  
 Jackson, MS 39225-2309  
 (601)961-5210  
 (601) 360-0535 (fax)

County: Madison  
 Permit #: \_\_\_\_\_  
 Driller: Travis West  
 Date completed: 6-13-2021  
*Copy information from block on Part 1*

**For Office Use Only:**

Well #: L 37  
 Aquifer: \_\_\_\_\_

*This part of the report must be completed by a licensed water well contractor or a licensed pump installer. A copy of Part 1 of the report must be attached and both parts filed with the Department at the above address within 30 days of well completion.*

Well Owner Information			Well Location		
Owner Name: <u>Chuck Bell</u>			Latitude: <u>32.5792480</u> Longitude: <u>-90.2165696</u>		
Mailing Address: <u>541 Stokes Rd.</u>			Method of Lat/Long (check one): Conventional Survey _____, USGS quad _____, Hand-held GPS <input checked="" type="checkbox"/> , Survey-grade GPS _____		
<u>Flora</u>	<u>MS</u>	<u>39071</u>	<u>MW</u> $\frac{1}{4}$ <u>SE</u> $\frac{1}{4}$ , Sec <u>32</u> T <u>9N</u> R <u>1E</u>		
City	State	Zip Code	<u>5.9</u> Miles <u>ENE</u> of <u>Flora</u>		
Telephone No. (____) _____			(Distance) (Direction) (Nearest Town)		

**Pump Type (check one)**

Submersible  Turbine  Air Lift  Centrifugal  Flowing Well  Jet  Piston  Rotary  Other (describe): \_\_\_\_\_

Date Pump Installed: 6-14-2021 Rated Pump Capacity: 55 Gallons Per Minute

Is This Pump (check one):  New  Repaired  Replacement

**Power Type (check one)**

Electric  Diesel  Gasoline  Natural Gas  Tractor PTO  Windmill  Other (describe): \_\_\_\_\_

Horse Power Rating of Motor: 5 Setting Depth: 189 feet Number of Stages: \_\_\_\_\_

**Pump Test Data for Non Flowing Well**

Date Well Tested: \_\_\_\_\_ Duration of Pump Test (minimum 4 hours): \_\_\_\_\_ hours

Static Water Level (A): \_\_\_\_\_ Feet Below Land Surface Pumping Water Level (B): \_\_\_\_\_ Feet Below Land Surface

Drawdown [(B) - (A)]: \_\_\_\_\_ Feet Below Land Surface Test Pumping Rate: \_\_\_\_\_ Gallons Per Minute

Method of measurement (check one): Steel tape  Electric tape  Air line  Other (describe): \_\_\_\_\_

**Pump Test Data for Flowing Well**

Measured shut in head: \_\_\_\_\_ feet.

Well yielded \_\_\_\_\_ GPM with a drawdown of \_\_\_\_\_ feet after \_\_\_\_\_ hours of pumping

**Meter Installation**

Meter Manufacturer: \_\_\_\_\_ Meter Serial Number: \_\_\_\_\_

Meter Model Number/Name: \_\_\_\_\_ Type of Meter: \_\_\_\_\_

Totalizer Register Unit and Multiplier Factor (AF x .001, gal x 1000, etc): \_\_\_\_\_

Installation Date: \_\_\_\_\_ Meter installed by: \_\_\_\_\_

Is This Meter (check one):  New  Repaired  Replacement

RECEIVED  
JUL 16 2021  
BY OLWR

*Important: By submitting the above information you are certifying that this meter was installed to manufacturer standards. For agricultural wells, a list of approved meters is on the MDEQ website.*

I HEREBY CERTIFY that the above statements are true to the best of my knowledge.

Travis West UNR-0010622 7-5-2021

Print Name of Pump Installer and License No. (if applicable) Date Signature of Pump Installer