

MADISON
M

MISSISSIPPI BOARD OF WATER COMMISSIONERS

9-14-63

WATER WELL DRILLERS LOG

Date: 9/14, 1963, Driller: M. Kay County Madison
(Name)

(1) Owner of Land: T-P RANCH
(Name)
R1 - Canton
(Address)

(2) Location: 1/4, 1/4, Sec. T R,
8 miles W, of Canton
(distance) (direction) (Nearest Town)

(3) Topography: (Hilly) (Flat) (Level)

(4) Purpose of Well: (Domestic Irrigation)
 (Municipal, Industrial, Other)

Description & Color of Materials Sand, Clay, Red Clay, Shell, etc.	Thick- ness Feet	Depth Feet
<u>Yellow clay</u>	<u>0</u>	<u>-21</u>
<u>Blue clay</u>	<u>21</u>	<u>168</u>
<u>marshy Brandy</u>	<u>168</u>	<u>214</u>
<u>B. clay</u>	<u>214</u>	<u>263</u>
<u>Sandy clay</u>	<u>263</u>	<u>300</u>
<u>Light Sand</u>	<u>300</u>	<u>315</u>
<u>1.0" clay</u>	<u>315</u>	<u>336</u>
<u>Fine Sand</u>	<u>336</u>	<u>378</u>
<u>marshy Sand</u>	<u>378</u>	<u>399</u>
<u>med Sand</u>	<u>399</u>	<u>410</u>

Information upon completion of well:

(1) Diameter 2 inches.

(2) Total Depth 400 feet.

(3) Water Level 74 feet below top of ground.

(4) Cased to _____, Size _____.

(5) Screen: Size 007, Length 20.


(6) Were any formations sealed against pollution?
 yes, no.

3 HP air unit

If YES depth of formation _____

Why _____

Drillers Remarks: _____

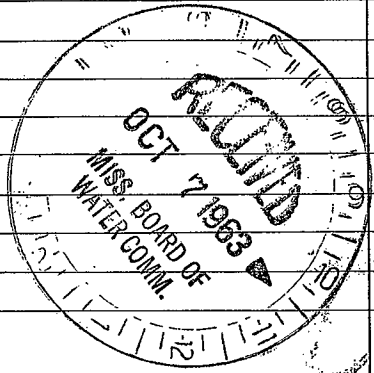

(Use Back Side)

Well No.

