

MADISON MISSISSIPPI BOARD OF WATER COMMISSIONERS

M

8-12-65

WATER WELL DRILLERS LOG

Date Aug 12, 1965, Driller: M. Key County Madison

(1) Owner of Land: Nashaba  
(Name)  
Carton mine  
(Address)

(2) Location: 1/4, 1/4, Sec.      T.      R.       
5 miles N. W. of Carton  
(distance) (direction) (Nearest Town)

(3) Topography:       
(Hilly) (Flat) (Level)

(4) Purpose of Well: Home  
(Domestic Irrigation  
Municipal, Industrial, Other)

Description & Color of Materials Sand, Clay, Red Clay, Shell, etc.	Thick- ness Feet	Depth Feet
<del>Blue Clay</del> White	0	10
Blue Clay	16	26
Blue Clay	20	80
Light Clay-Sand	80	140
Blue Clay	140	180
Brown Shale	180	280
Sandy Clay	280	300
Sandy Clay	300	360
Sandy Clay	360	400
Blue Shale	400	460
Blue Shale	460	500
Blue Shale Sand Str.	500	620
" " " "	620	740
Brown Shale	740	820
Brown Shale	820	900
Sandy Shale	900	920
Fine Sand	920	940
Med Sand	940	980
3HP. 2 1/2" air unit		

Information upon completion of well:

(1) Diameter 7 inches.

(2) Total Depth 980 feet.

(3) Water Level 44 feet below top of ground.

(4) Cased to     , Size     


(5) Screen: Size 007, Length 30

(6) Were any formations sealed against pollution?  
     yes, ✓ no.

If YES depth of formation     

Why     

Drillers Remarks:     

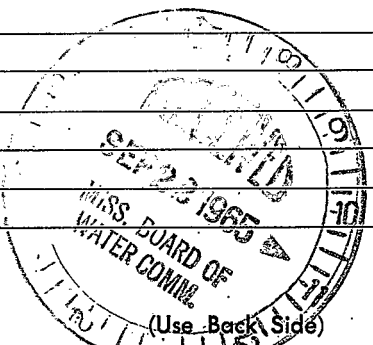

Well No.

