

MADISON

M

WATER WELL DRILLERS LOG

2-1-66

Date: Feb 1, 1966; Driller: M. C. KAY County: MADISON

(Name)

(1) Owner of Land: TOM RIDDELL (Name)

Canton (Address)

(2) Location: 1/4, 1/4, Sec. 2 T 8 R E

5 miles NW of Canton (distance) (direction) (Nearest Town)

(3) Topography: (Hilly) (Flat) (Level)

(4) Purpose of Well: Home (Domestic Irrigation Municipal, Industrial, Other)

Description & Color of Materials Sand, Clay, Red Clay, Shell, etc.	Thick- ness Feet	Depth Feet
Red clay	0	20
Blue clay	20	40
Blue clay	40	80
Sandy clay	80	105
Sandy clay	105	160
Blue clay	160	220
Blue clay	220	280
Blue clay	280	300
Sandy clay	300	340
Med Sand	340	380

Information upon completion of well:

(1) Diameter 2 inches.

(2) Total Depth 380 feet.

(3) Water Level 68 feet below top of ground.

(4) Cased to, Size

(5) Screen: Size 007, Length 20

(6) Were any formations sealed against pollution?


yes, no.

If YES depth of formation

Why

Drillers Remarks:

air Pumping

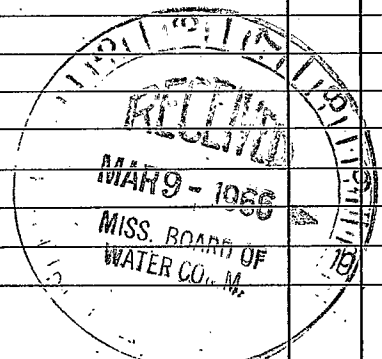

(Use Back Side)

Well No.

