

MADISON
M

MISSISSIPPI BOARD OF WATER COMMISSIONERS

5-10-62

WATER WELL DRILLERS LOG

Date: 5/10, 1962, Driller: Jesse W. Gray County Madison
(Name)

(1) Owner of Land: STATE HIGHWAY
(Name)
T.L. Jesse Const Co.
(Address)

(2) Location: 1/4, 1/4, Sec. T. R.
7 miles SW of Canton
(distance) (direction) (Nearest Town)

(3) Topography: (Hilly) (Flat) (Level)

(4) Purpose of Well: Water Road Bed
(Domestic Irrigation
Municipal, Industrial, Other)

Description & Color of Materials Sand, Clay, Red Clay, Shell, etc.	Thick- ness Feet	Depth Feet
<u>yellow clay</u>	<u>0</u>	<u>21</u>
<u>" "</u>	<u>21</u>	<u>42</u>
<u>Blue clay</u>	<u>42</u>	<u>63</u>
<u>" "</u>	<u>63</u>	<u>84</u>
<u>" "</u>	<u>84</u>	<u>105</u>
<u>" "</u>	<u>105</u>	<u>124</u>
<u>" "</u>	<u>126</u>	<u>147</u>
<u>" "</u>	<u>147</u>	<u>168</u>
<u>" "</u>	<u>168</u>	<u>189</u>
<u>" "</u>	<u>189</u>	<u>210</u>
<u>Sandy clay</u>	<u>210</u>	<u>231</u>
<u>clay</u>	<u>231</u>	<u>252</u>
<u>clay</u>	<u>252</u>	<u>273</u>
<u>Sandy clay</u>	<u>273</u>	<u>294</u>
<u>" "</u>	<u>294</u>	<u>315</u>
<u>" "</u>	<u>315</u>	<u>336</u>
<u>Fine Sand</u>	<u>336</u>	<u>357</u>
<u>Fine Sand</u>	<u>357</u>	<u>378</u>
<u>Med Sand</u>	<u>378</u>	<u>399</u>
<u>Med Sand</u>	<u>399</u>	<u>420</u>
<u>Med Sand</u>	<u>420</u>	<u>441</u>
<u>Med Sand</u>	<u>441</u>	<u>462</u>

Information upon completion of well:

(1) Diameter 4 X 2 1/2 inches.

(2) Total Depth 462 feet.

(3) Water Level 78 feet below top of ground.

(4) Cased to 315, Size 4"


(5) Screen: Size 208, Length 30ft

(6) Were any formations sealed against pollution?
no

If YES depth of formation _____

Why _____

Drillers Remarks _____

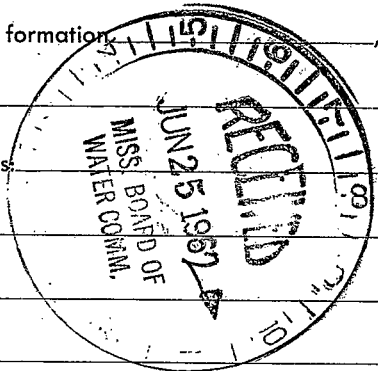

S.H.P. Sub. Pumping
about 80 years min.

(Use Back Side)

Well No.

[The page contains extremely faint and illegible text, likely bleed-through from the reverse side of the document. No specific content can be transcribed.]