

CODED

MISSISSIPPI BOARD OF WATER COMMISSIONERS  
416 North State Street  
Jackson, Mississippi 39201

WATER WELL DRILLERS LOG

Madison  
M31  
7-25-69

7/25/69 19 Forest Dulling Madison  
date well completed firm name county/well located

LANDOWNER:  
Perry Murphy  
Center, Miss.  
(mailing address)

description of formations encountered	from	to
Clay	0	23
sand & clay	23	40
Clay + silt sand	40	61
fine sand & silt	61	122
fine sand	122	143

WELL LOCATION:  
sec. 31 T. 9 N R. 1 E  
6 miles SW of Center  
(distance) (direction) (nearest town)

WELL PURPOSE: Home  
(home, irrigation, municipal, industrial)

WELL COMPLETION DATA:

(1) diameter (inches) 4"

(2) total depth (feet) 130'

(3) static water level (feet) 15' below top of ground

(4) casing Steel 110'  
(material) (depth)  
4" if telescope see back.  
(size)

(5) screen 20' 110'  
10'-3" (length) (depth to top)  
10'-4" (size) Stainless Steel (material)

(6) pump 2 HP 40  
(HP) (yield gpm)  
Electric  
(type power)

(7) electric log no  
(yes or no)

(organization running log)

(8) how well bottom plugged 2" gravel  
value


OCT 3 - 1969

MISSISSIPPI BOARD OF WATER COMMISSIONERS

DRILLERS REMARKS:

If well telescopes please sketch and show depths.

GROUND LEVEL

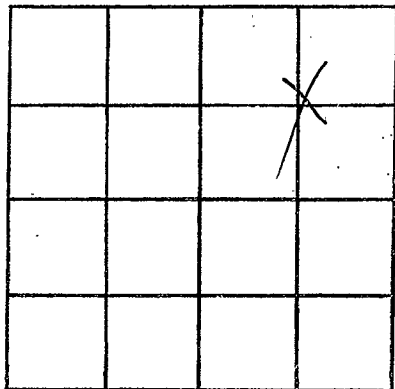

SECTION 31

Please indicate well location X.

ADDITIONAL INFORMATION

If more than one screen,  
show locations of each on sketch.