

MADISON

M 33

6-15-61

CCNY

WATER WELL DRILLERS LOG

CODED

Date: 6/15, 1961, Driller: M. E. Kay County: Madison

(1) Owner of Land: Tom Mc Ferrin
(Name)
Canton Mass
(Address)

(2) Location: 1/4, 1/4, Sec. 36 T 9 R 2E
1 miles S of Canton
(distance) (direction) (Nearest Town)

(3) Topography: (Hilly) (Flat) (Level)

(4) Purpose of Well: Home
(Domestic Irrigation
Municipal, Industrial, Other)

Description & Color of Materials Sand, Clay, Red Clay, Shell, etc.	Thick- ness Feet	Depth Feet
White Clay	0	21
Blue Clay	21	42
" "	42	63
" "	63	84
" "	84	105
Sand Clay	105	124
" "	124	147
Blue Clay	147	168
" "	168	189
" "	189	210
Sand Clay	210	231
" "	231	252
Sand Siltstone	252	273
Clay	273	294
Fine Sand	294	315
" "	315	336
" "	336	357
" "	357	378
" "	378	399
Coarse Sand	399	400

Information upon completion of well:

(1) Diameter 2 inches.

(2) Total Depth 400 feet.

(3) Water level 73 feet below top of ground.

(4) Cased to _____, Size _____

(5) Screen: Size 009, Length 10ft.


(6) Were any formations sealed against pollution?
_____ yes, no.

If YES depth of formation _____

Why _____

Drillers Remarks: _____

air pump

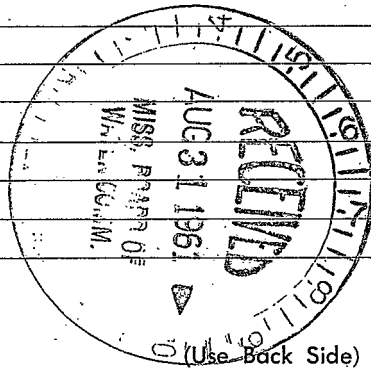

Well No.

