

M 34

1-2-63

WATER WELL DRILLERS LOG

**CODED**

Date: Jan 2, 1963, Driller: M<sup>rs</sup> Kay County Madison  
(Name)

(1) Owner of Land:	Description & Color of Materials Sand, Clay, Red Clay, Shell, etc.	Thick- ness Feet	Depth Feet
<u>Wayman Sowell</u> <small>(Name)</small>	<u>Yellow Clay</u>	0	21
<u>Canton Miss.</u> <small>(Address)</small>	<u>White Clay</u>	21	42
Location: <u>2 3/6</u> <u>9 2E</u> <small>1/4, 1/4, Sec. T. R.</small>	" " "	42	63
<u>6</u> miles <u>W</u> of <u>Canton</u> <small>(distance) (direction) (Nearest Town)</small>	<u>Blue Clay</u>	63	189
Topography: <input checked="" type="checkbox"/> (Hilly) <input type="checkbox"/> (Flat) <input type="checkbox"/> (Level)	<u>Mucky Brack Sand</u>	189	210
Purpose of Well: <u>Home</u> <small>(Domestic Irrigation, Municipal, Industrial, Other)</small>	<u>Shell Sand</u>	210	231
	<u>Sandy Clay</u>	231	254
	<u>Sandy Clay</u>	252	273
	<u>Blue Clay</u>	273	315
	" " "	315	336
	<u>Sandy Clay</u>	336	328
	<u>Sand - Siltite</u>	328	399
	<u>Fine Sand</u>	399	504
	<u>Sand - Clay STBA</u>	504	525
	<u>Fine Sand</u>	525	546
	<u>Med Sand</u>	546	588
	<u>clay - sand</u>	588	-

Information upon completion of well:

(1) Diameter 2 inches.

(2) Total Depth 588 feet.

(3) Water Level 74 feet below top of ground.

(4) Cased to \_\_\_\_\_, Size 2 1/2.

(5) Screen: Size 007, Length 20.


(6) Were any formations sealed against pollution?  
 yes,  no.

If YES depth of formation \_\_\_\_\_

Why \_\_\_\_\_

Drillers Remarks: \_\_\_\_\_

1 HP.  
 Jet **CODED**  
 105 ft Jet Pump

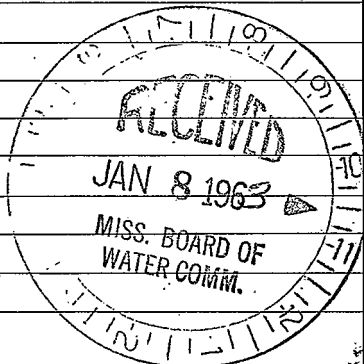

(Use Back Side)

Well No.

