

OM35

5-6-63

WATER WELL DRILLERS LOG

CODED

Date: 5/6, 1963, Driller: M. E. Key, Marion Davis County, Madison

(1) Owner of Land: Marion Davis (Name) Canton Miss (Address)

(2) Location: 1/4, 1/4, Sec. 17, T. 9 R. 2 E, 10 miles W of Canton (Nearest Town)

(3) Topography: (Hilly) (Flat) (Level)

(4) Purpose of Well: (Domestic Irrigation, Municipal, Industrial, Other)


Table with 3 columns: Description & Color of Materials, Thickness Feet, Depth Feet. Rows include White Clay, Blue Clay, Muddy Branch, Brown Clay, Sand, Med Sand.

Information upon completion of well:

- (1) Diameter 2 inches. (2) Total Depth 346 feet. (3) Water Level 22 feet below top of ground. (4) Cased to... Size... (5) Screen: Size 006, Length 10ft. (6) Were any formations sealed against pollution? yes, no.

Handwritten signature: K. H. P. J.

CODED

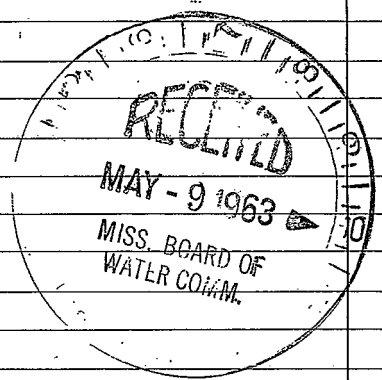

If YES depth of formation Why Drillers Remarks:

(Use Back Side)

Well No.

